


T. 3 S., R. 44 E., W.M.

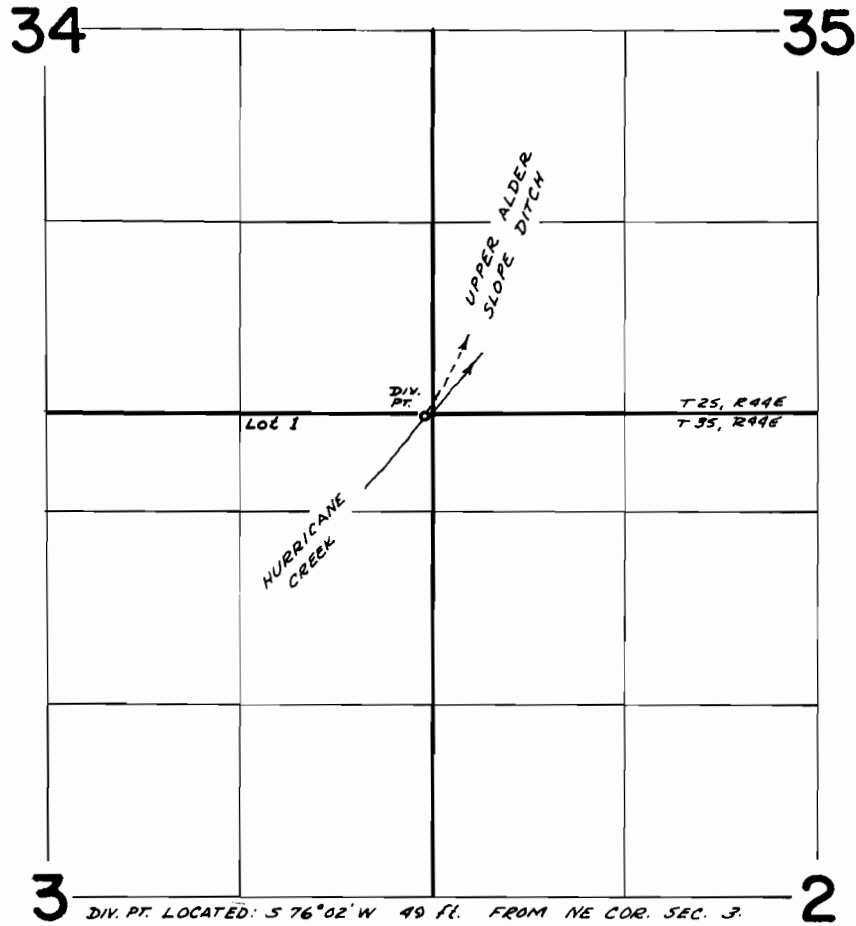

**FINAL PROOF SURVEY**  
UNDER

Transfer Nos. 2350, 2380, 2381, 2399

Application No. .... Permit No. ....

IN NAME OF

PINE TREE PIPELINE ASSOC.

Surveyed June 27, 1972, by L. E. Gould