


RECEIVED


JUN 9 1970

STATE ENGINEER  
SALEM, OREGON

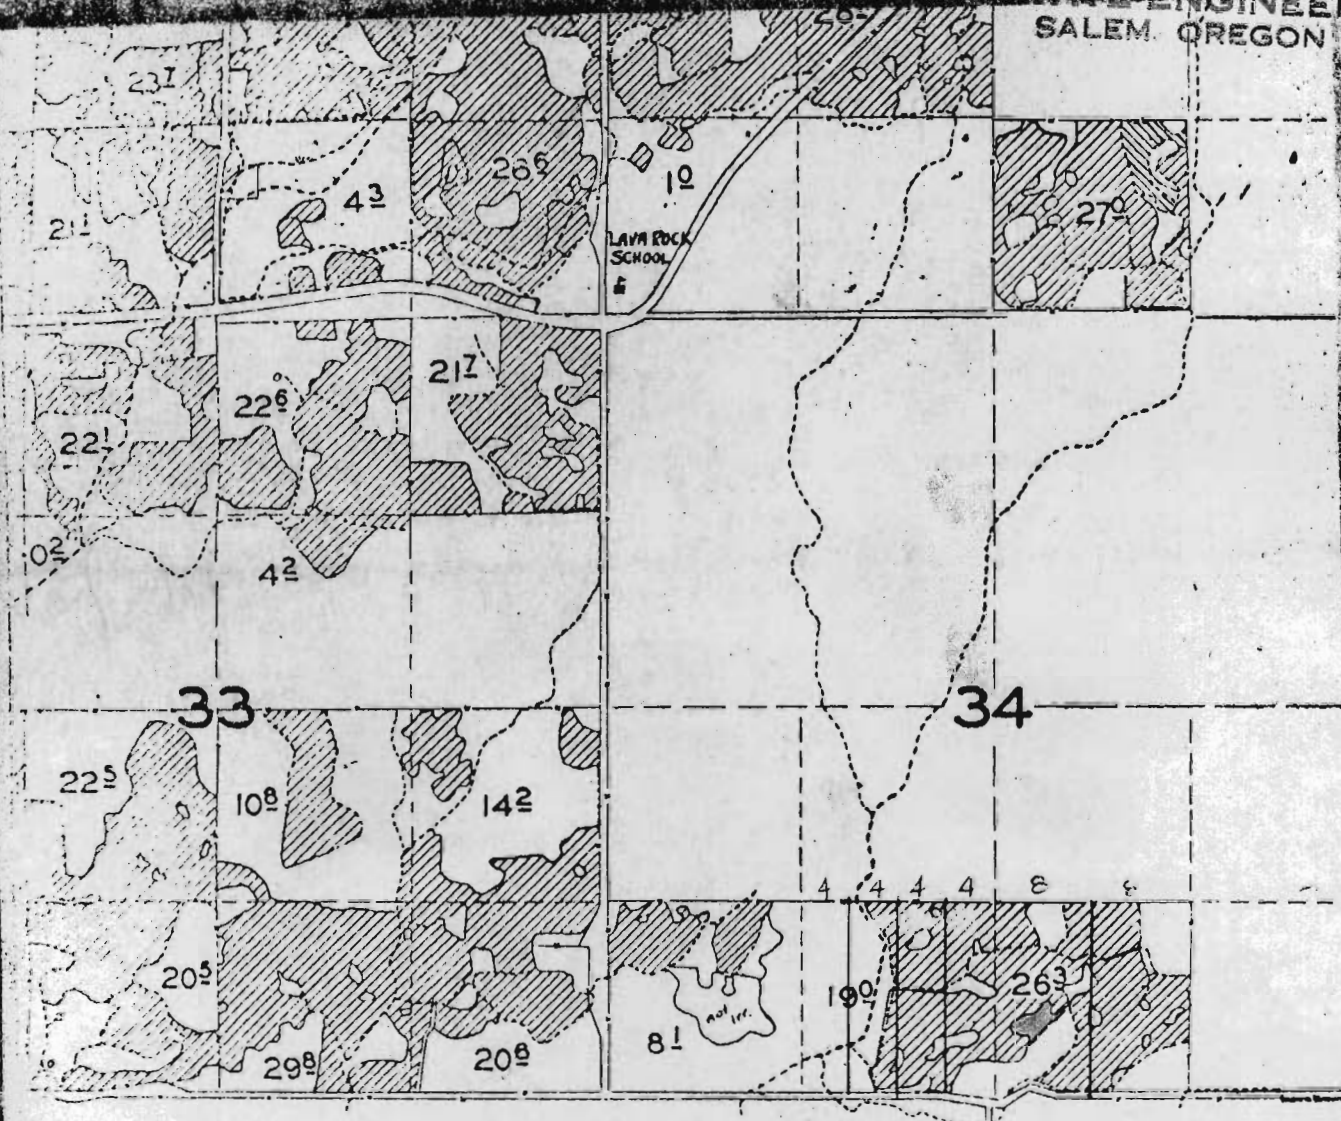

Transfer off 1.2 Acre

RECEIVED  
JUN 9 1970  
STATE ENGINEER  
SALEM OREGON

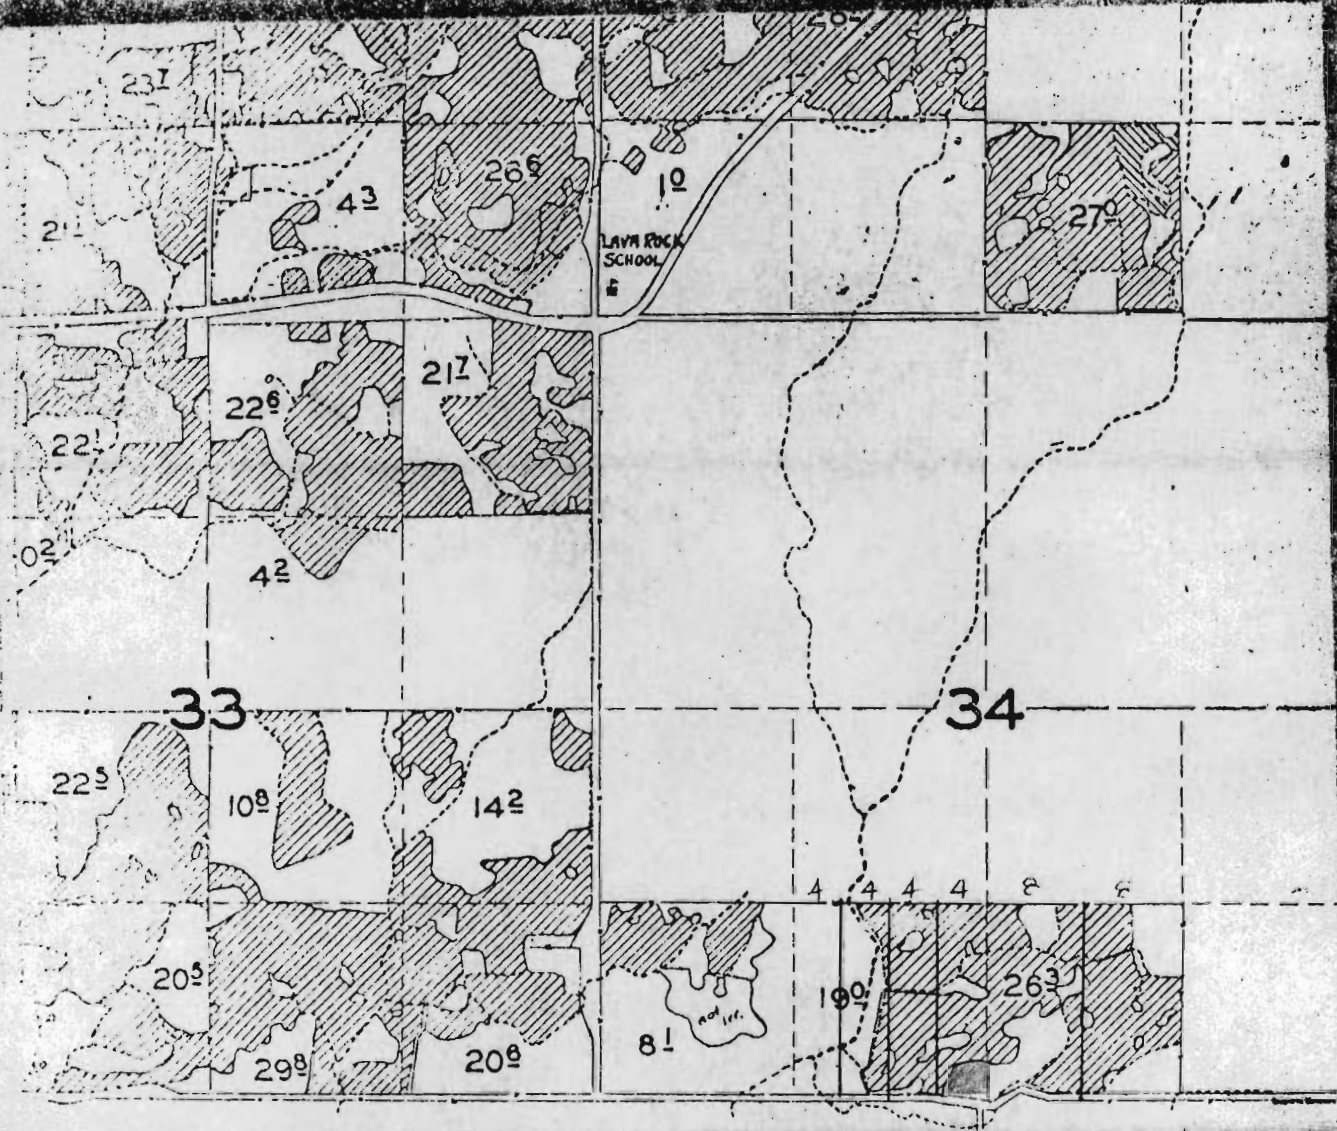

Transfer on 1.0 Acre