


T. 2405 & 2406

T. 18 S R 14 E
Lands transferred to

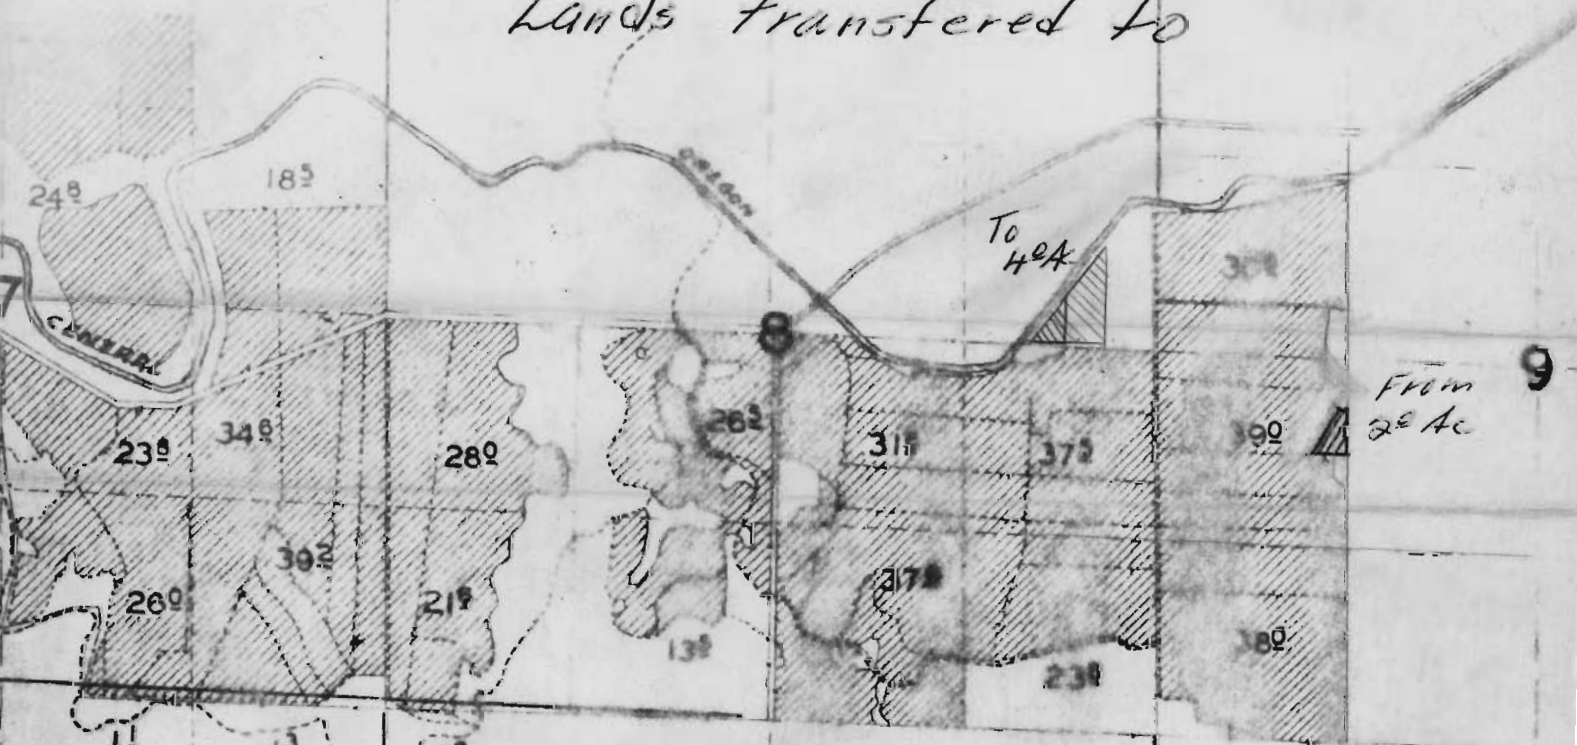

From
2nd Ac

RECEIVED
JUN 19 1970

STATE ENGINEER
SALEM OREGON

RECEIVED
JUL 27 1970

STATE ENGINEER
SALEM OREGON