


T.13S.,R.1&2E.,W.M.

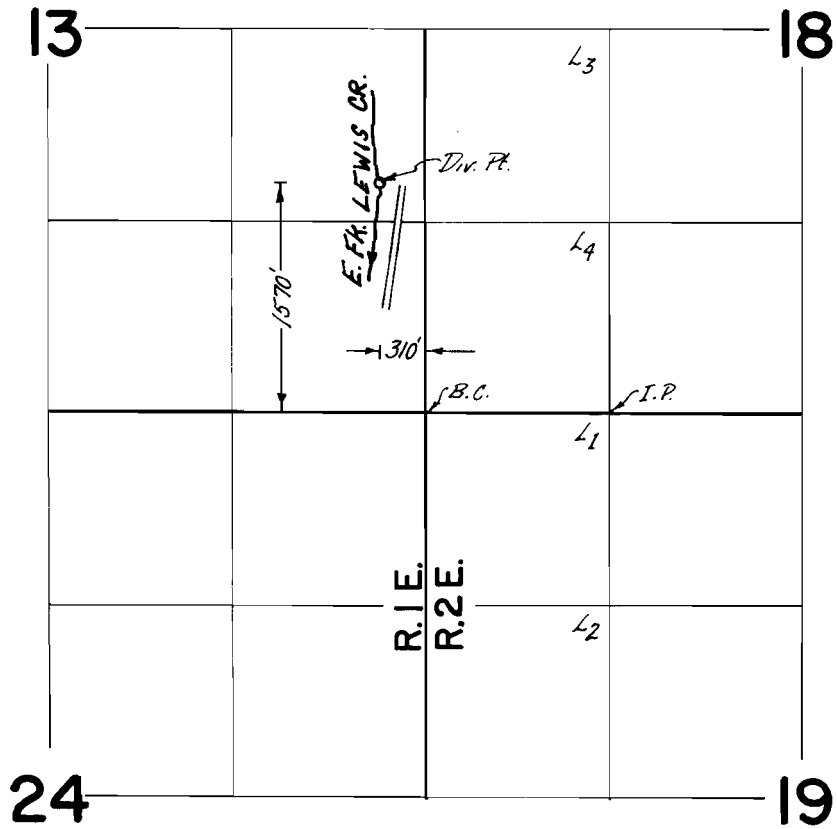

FINAL PROOF SURVEY
UNDER

Transfer No. 2415

Application No. Permit No.

IN NAME OF

..... HERBERT HUGHES

Surveyed 20 Sept. 1972, by D. Norby