


T. 36 S., R. 2 E., W. M.

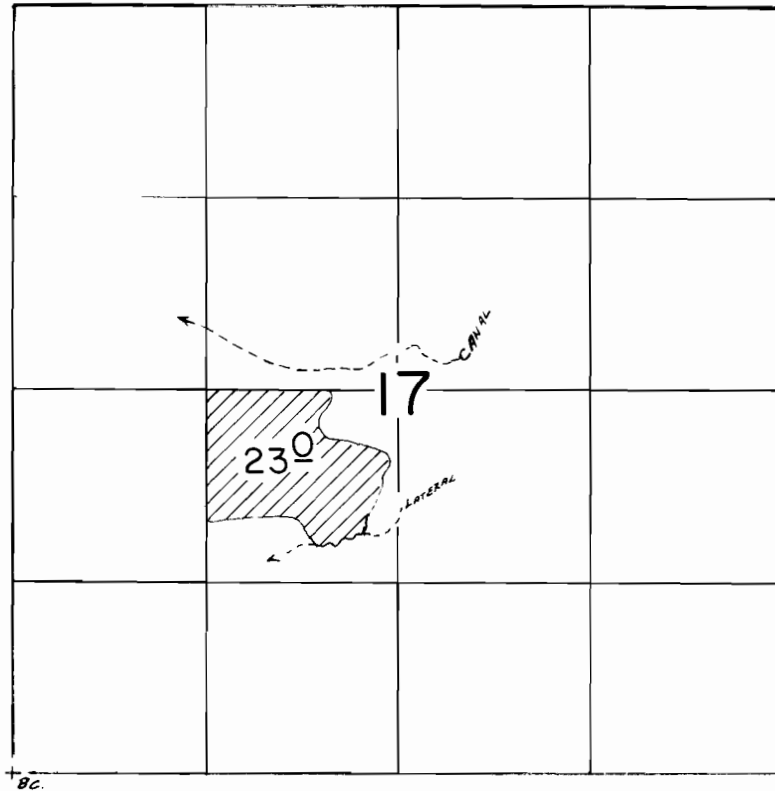

Scale 1" = 1320'

**FINAL PROOF SURVEY**  
UNDER

Transfer No. 2416

Application No. .... Permit No. ....

IN NAME OF

..... C-2 CATTLE CO. ....

Surveyed June 27, 1989, by B.S. JAMES .....