T-2422 & 2423

RECEIVED
JUL 23 1970
STATE ENGINEER
SALEM, OREGON

T 5 S R 1 W

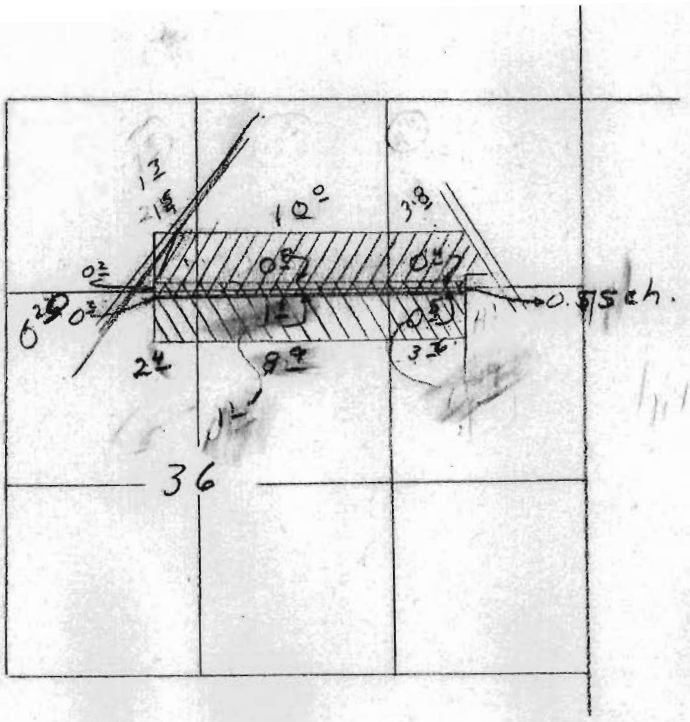

Transfer from

To