


T.7S. R.3&4W. W.M.

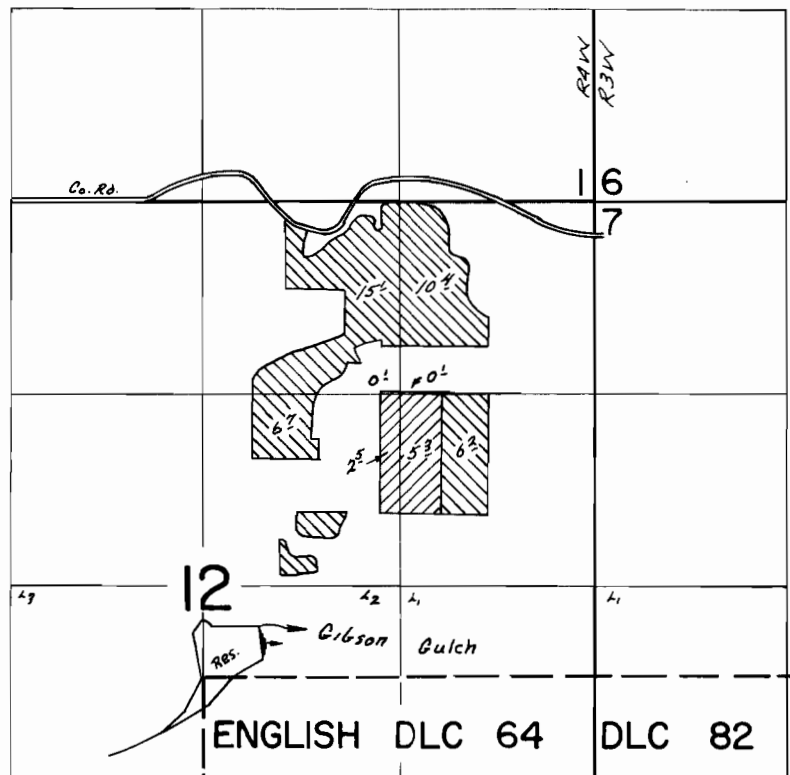

Dr. Pl. loc 400'S + 400'E From Center Sec 12

FINAL PROOF SURVEY
UNDER

Transfer No. 2439

Application No. 47455 Permit No. 35403

IN NAME OF

REX V. L. & DUANE GIBSON

Surveyed April 6 1973, by R.G. Mucken