T.29 S. R.12 W. W.M.

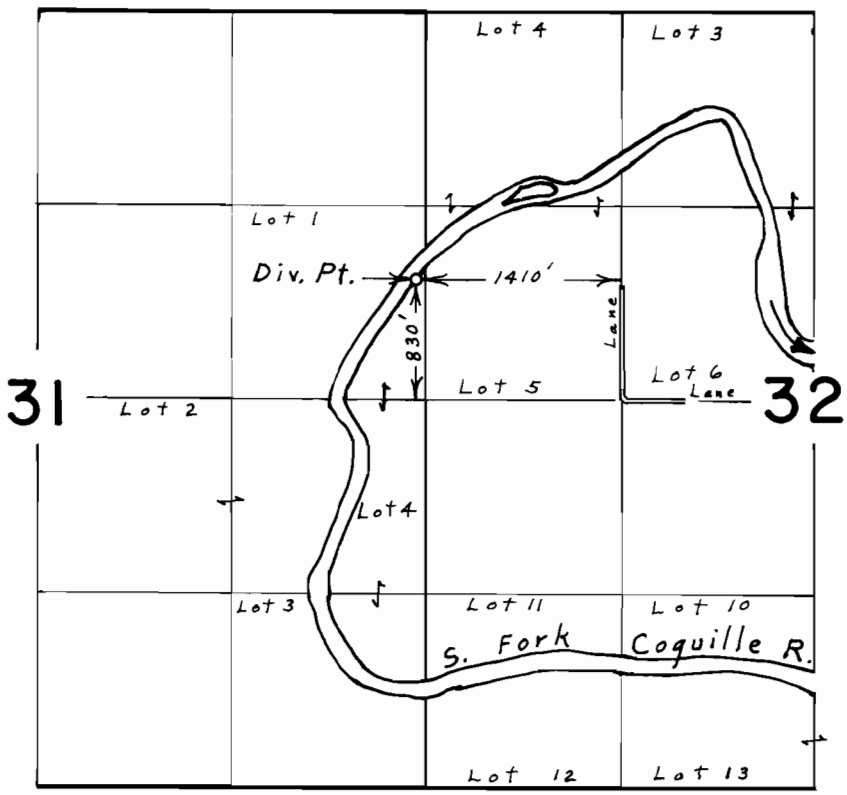

FINAL PROOF SURVEY
UNDER

Application No. ..... TRANSFER NO. 2441 Permit No. .....

IN NAME OF

GLENN GULSTROM

Surveyed Oct. 31, 1975, by L. E. Gould

COB-3HH-71 & 1975-M