


T. 35 S. R. 3 W. W.M.

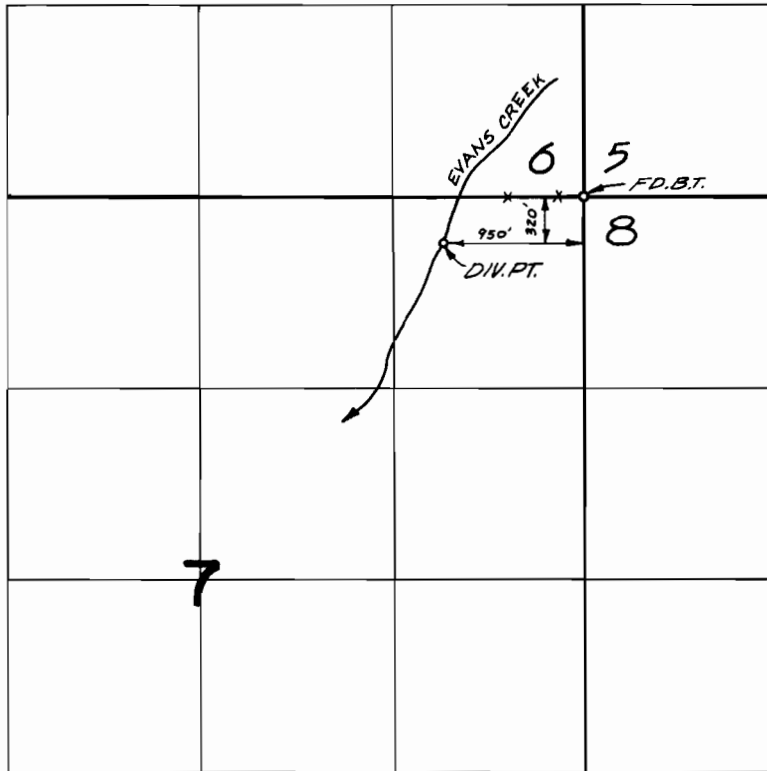

FINAL PROOF SURVEY
UNDER

TRANSFER NO. 2443
Application No. Permit No.
IN NAME OF

.....THEODORE B. CHENEY.....

Surveyed JULY 26 1974, by D. NORBY.....