


T.9 S. R.40 E. W.M.

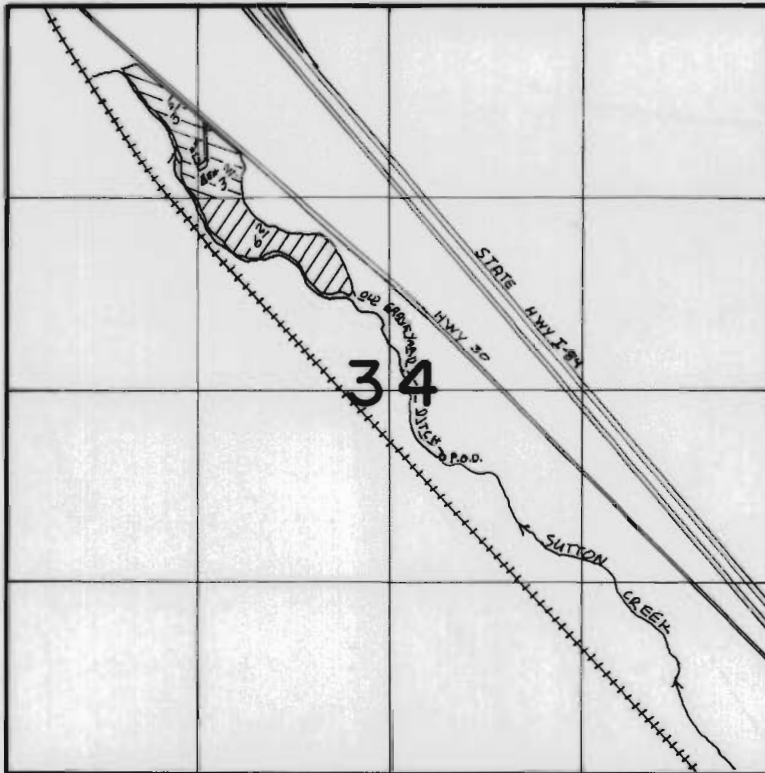

SCALE: 1"=1320'



POD LOCATED 360' EAST AND 450' SOUTH FROM THE C. 1/4 COR.  
SEC. 34



T-2445



T-2446

### FINAL PROOF SURVEY

UNDER

TRANSFER: T-2445, T-2446

IN NAME OF

.....**CHARLES C. EBELL**.....

Surveyed ...**7-30**... 19**84**., by **V.L. CHURCH**.....