


2478

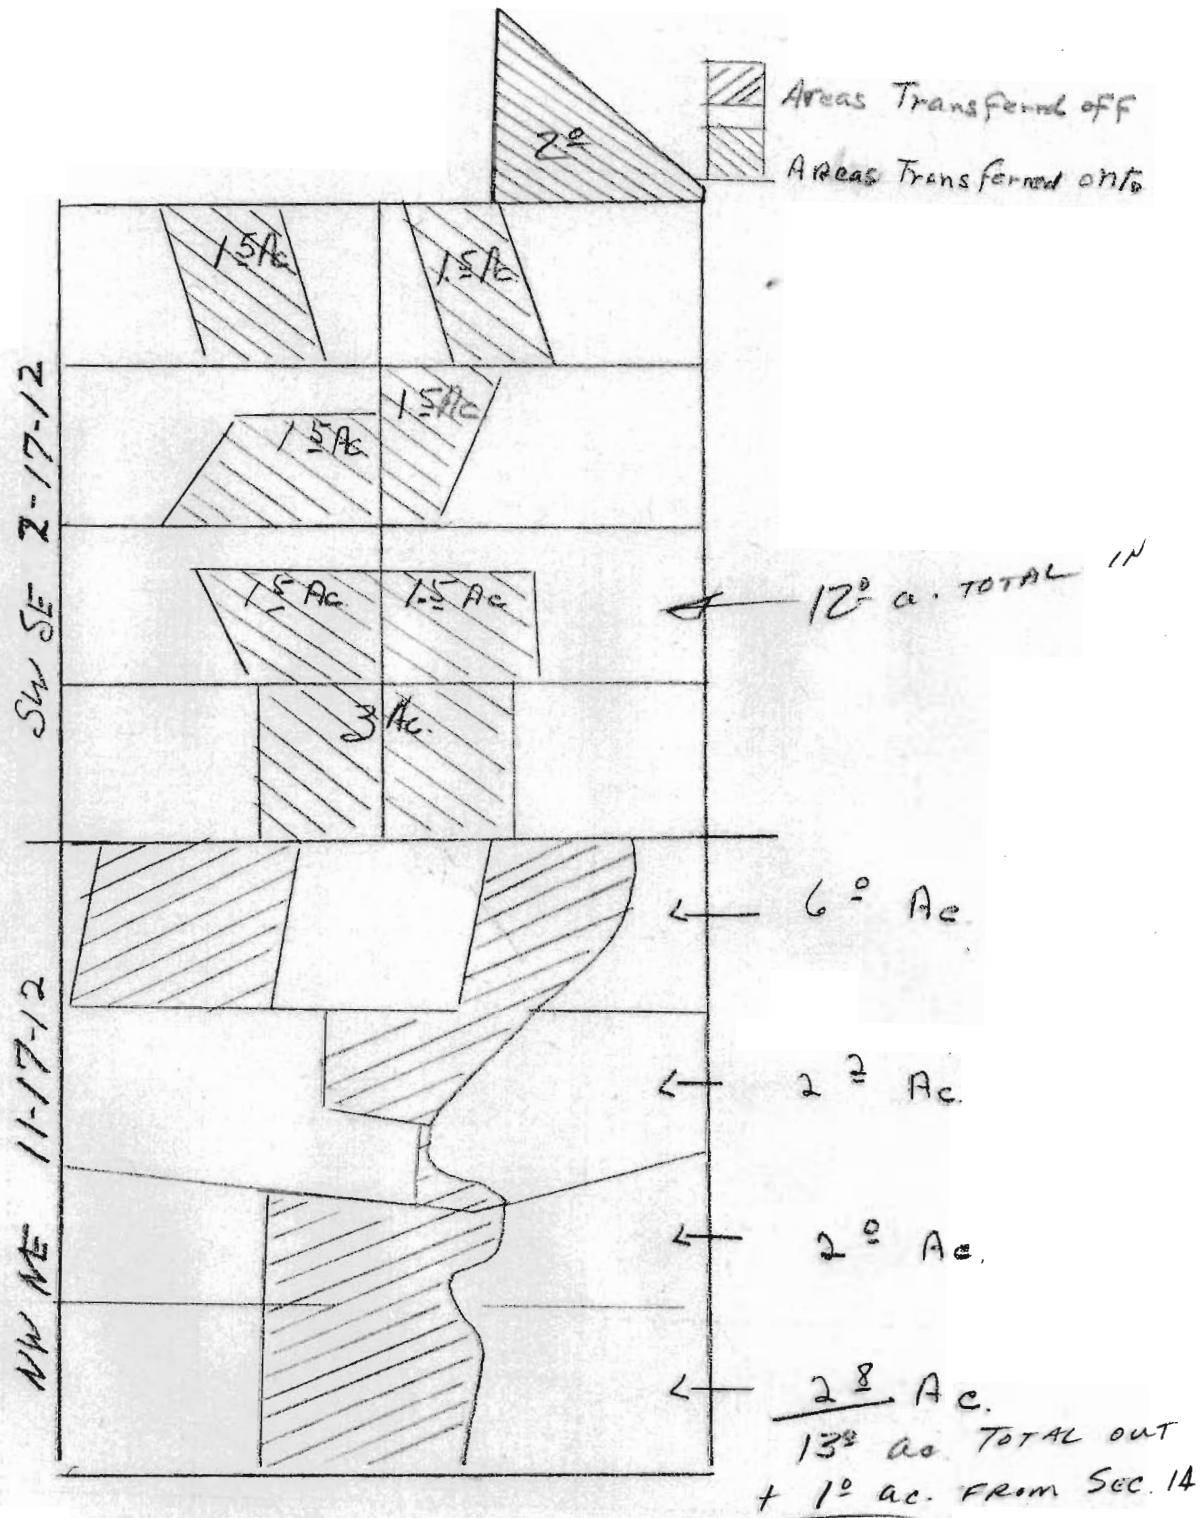

RECEIVED
 MAY 23 1971
 STATE ENGINEER
 SALEM, OREGON
JWJ