


T.1N.R.3W.W.M.

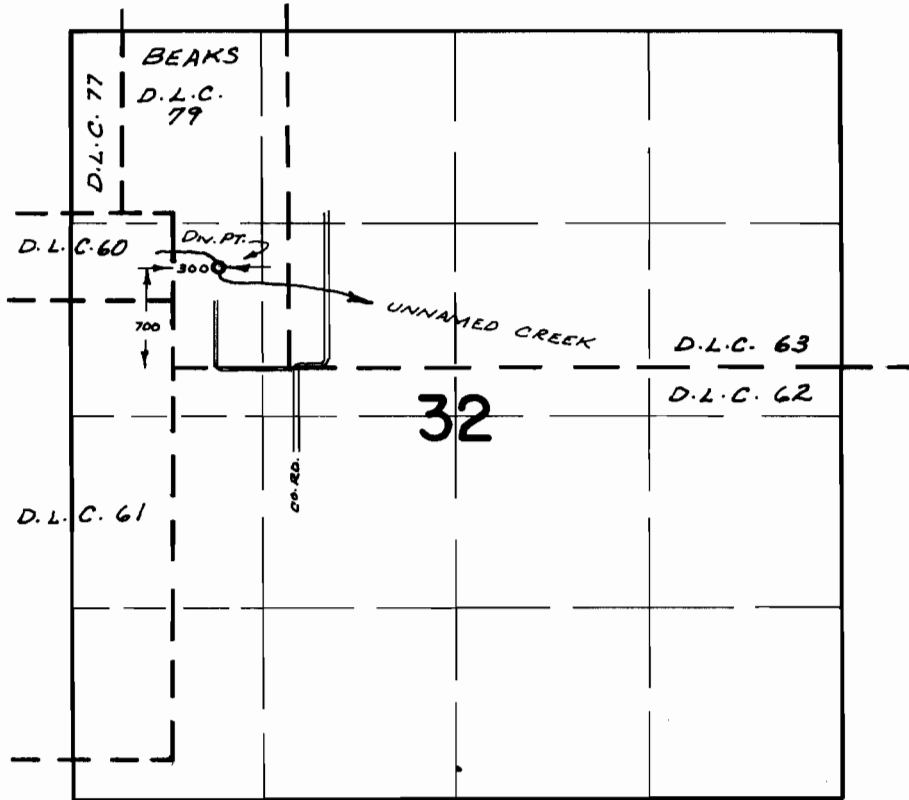

FINAL PROOF SURVEY UNDER

TRANSFER No. 2489
Application No. Permit No.
IN NAME OF

.....SYLVESTER VAN LOO.....

Surveyed SEPT. 20, 1972, by R. MUGGEN