


Sec. 5 T17S. R12 EWM.
 DESCHUTES COUNTY
 1"=400'

RECEIVED
 MAR 2 1971
 STATE ENGINEER
 SALEM, OREGON

17 12 5

See Map 16 12 32

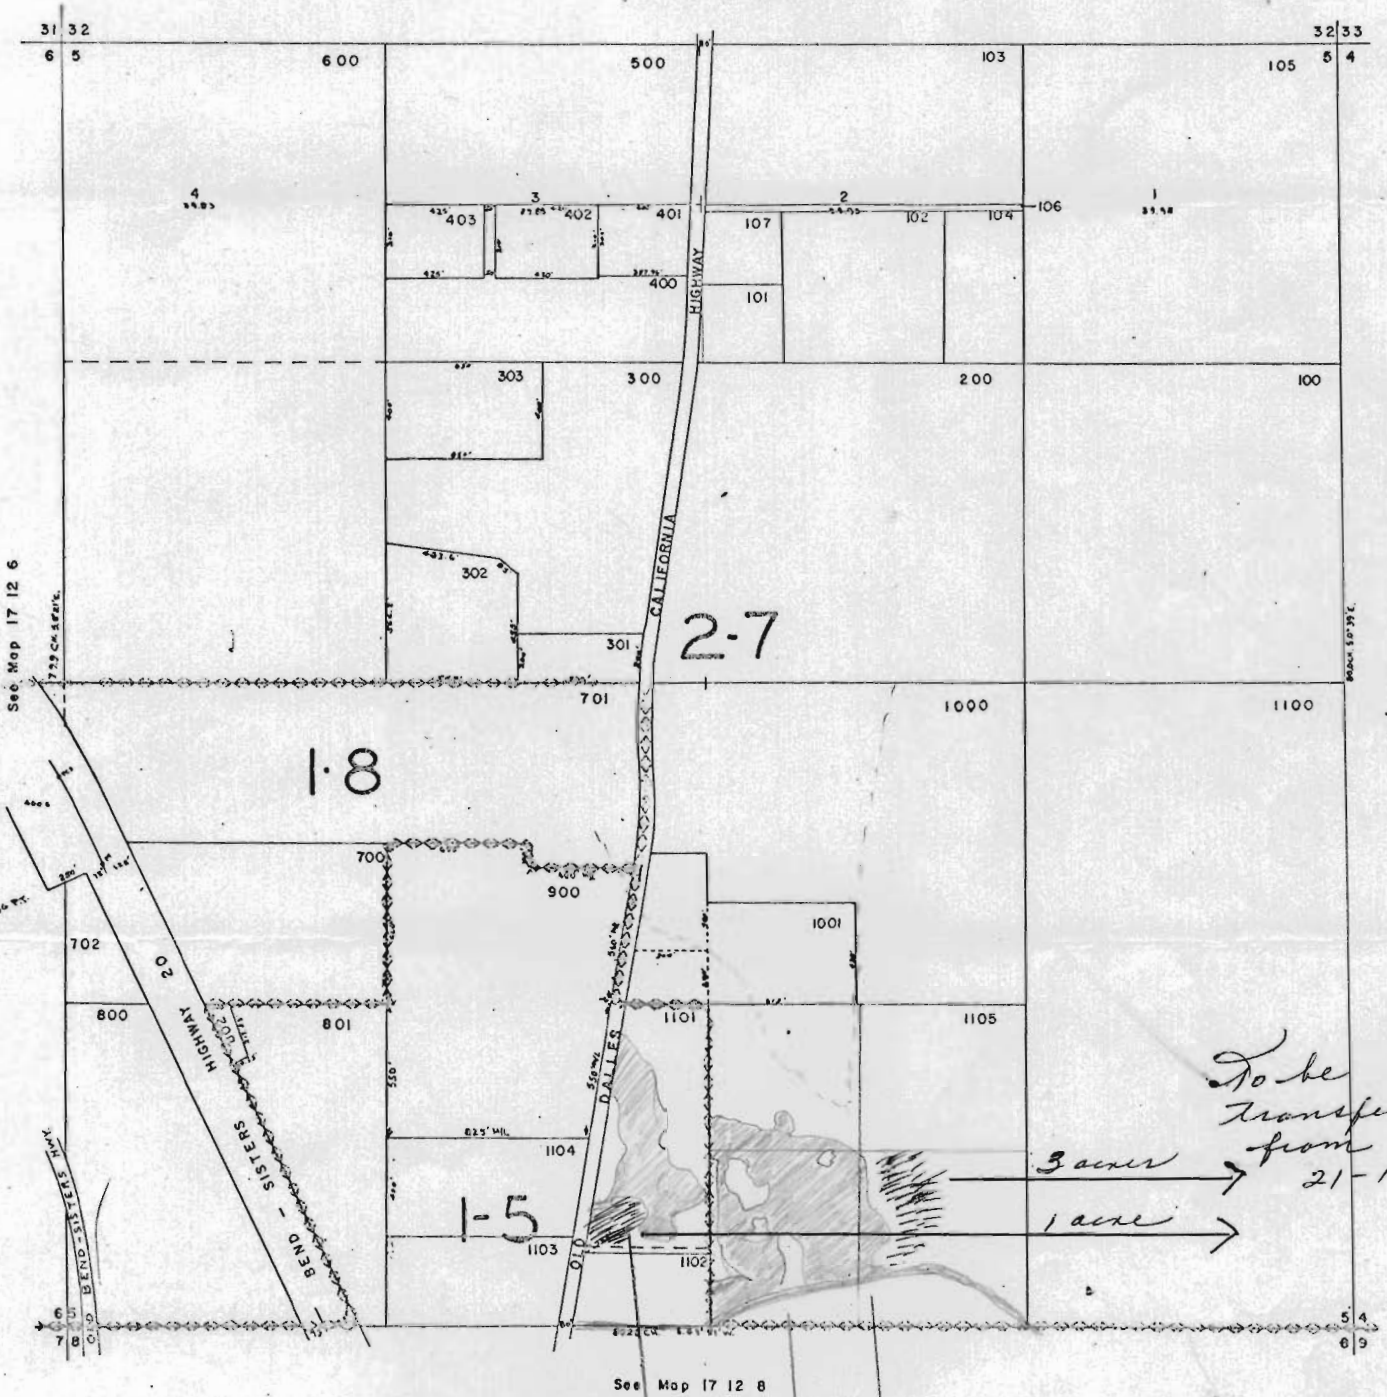

17 12

RECEIVED

MAR 17 1971

STATE ENGINEER
SALEM, OREGON

*3 for Samuel
1 for Steman
Section 5-17-12*

SEC. 21 T.17S. R.12 E.W.M.

DESCHUTES COUNTY

SCALE: 1" = 400'


RECEIVED

MAR 2 1971

STATE ENGINEER 7 12 21
SALEM, OREGON 1402

See Map 17 12 16C

See Map 17 12 16

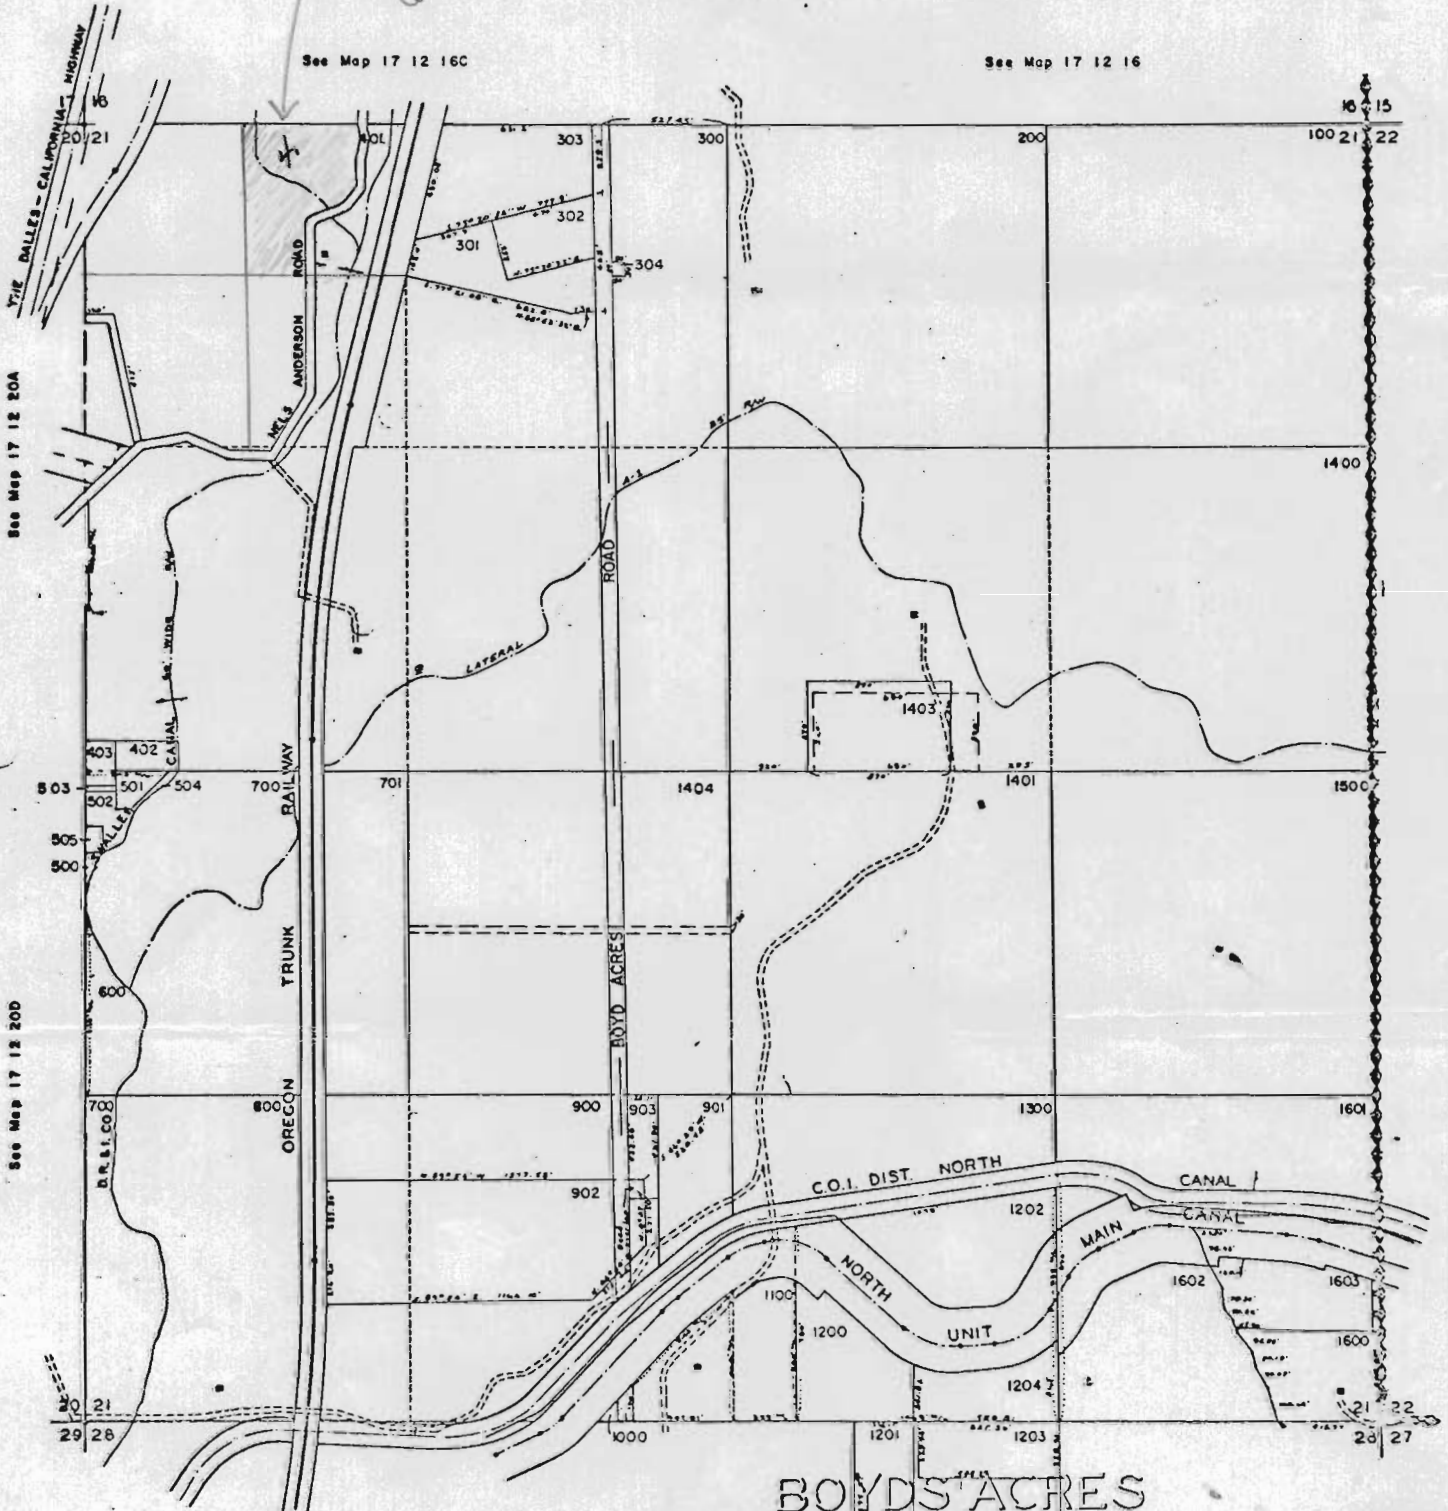

See Map 17 12 20A

See Map 17 12 20D

See Map 17 12 22

See Map 17 12 28B

See Map 17 12 28A

17 12 21