


T.36S.,R.IW.,W.M.

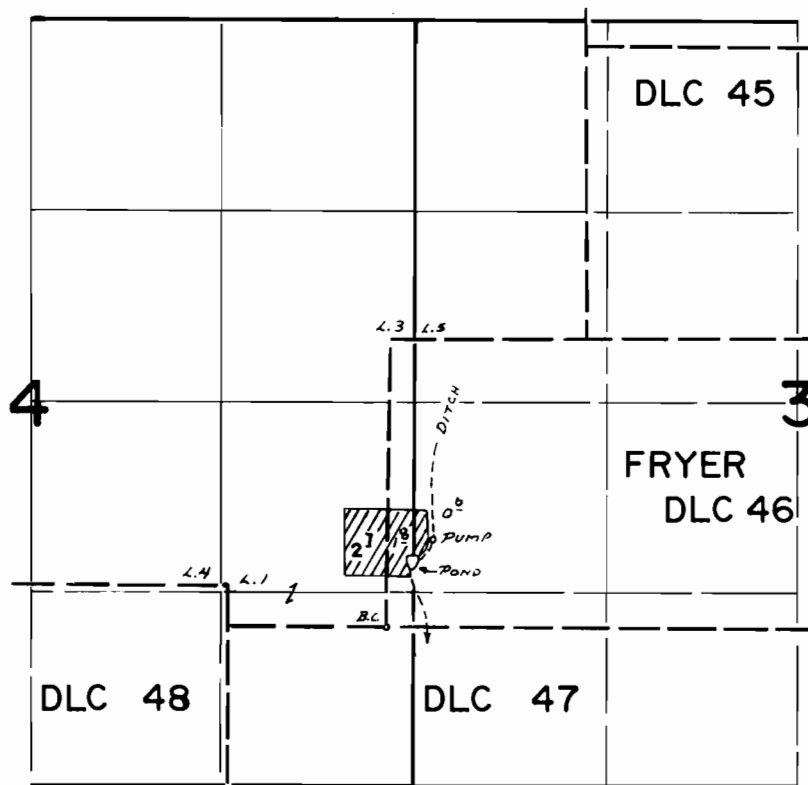

Div. Loc: 560' N AND 2990' E FROM SW COR. SEC. 31

FINAL PROOF SURVEY UNDER

Transfer No. 2493
Application No. Permit No.
IN NAME OF

RICHARD C. & HELEN M. WOLGAMOTT

Surveyed AUG. 19. 19.75, by L. E. GOULD