


T.16S., R.11E., W.M.

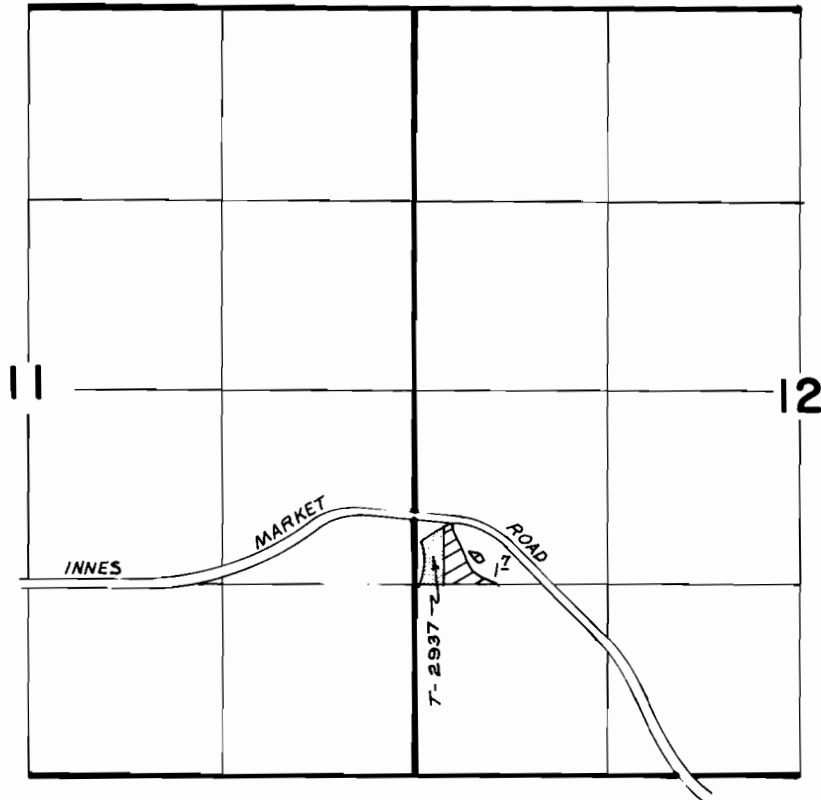

SCALE: 1"=1320'

FINAL PROOF SURVEY UNDER

TRANSFER NO. 2499

IN NAME OF

ARTHUR E. & PATRICIA D. MURRAY

Surveyed MAY 25 19 85, by LESLIE OLSON