

To

Sec 4 TWP 17 RANGE 11


2³ CERT 26508



7⁷A CERT 31410



10^A SUP 26051

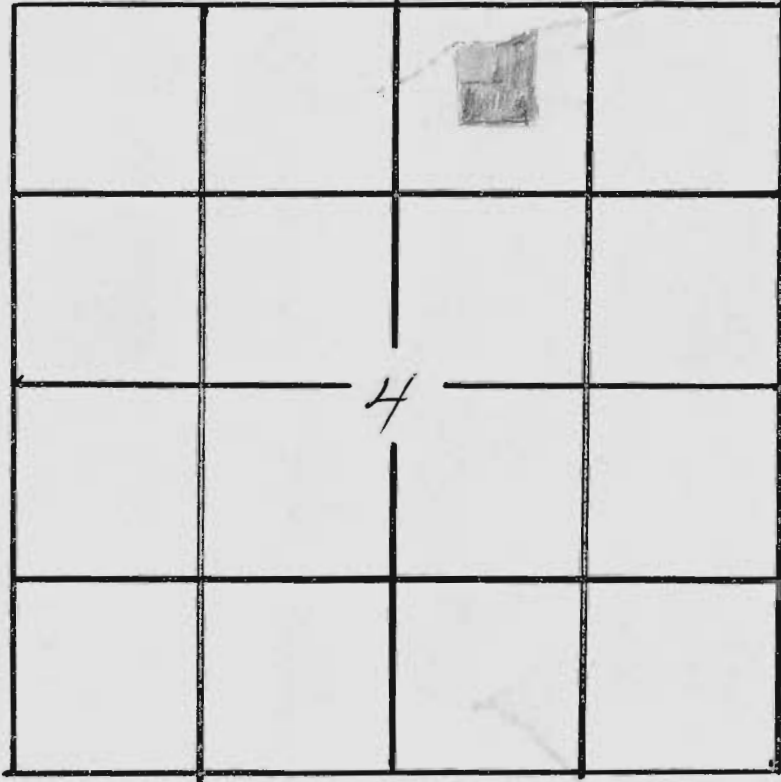

Transferred To Sec 4 T17S R11E NW $\frac{1}{4}$ NE $\frac{1}{4}$

Transferred From Sec 33 T16S R11E SW $\frac{1}{4}$ SE $\frac{1}{4}$

RECEIVED
APR 22 1971
STATE ENGINEER
SALEM, OREGON

FROM

Sec 33

TWP 16

RANGE 11


9³ A CERT 26508



7² A CERT 31410



10^A SUP 26051

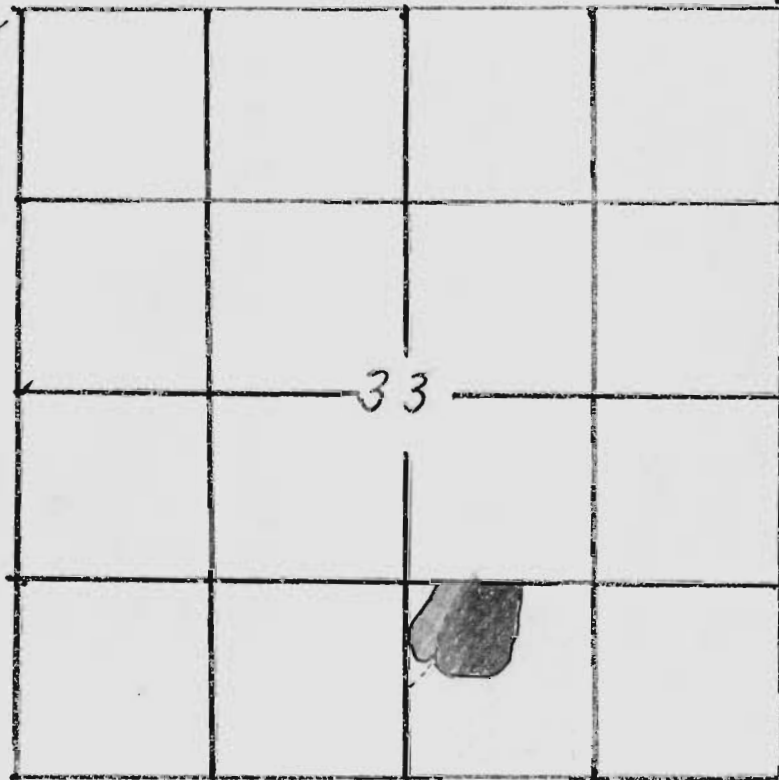

Transferred From SW 1/4 SE 1/4 33-16-11

Transferred To NW 1/4 NE 1/4 Sec 4-17-11

RECEIVED
APR 22 1971
STATE ENGINEER
SALEM, OREGON