


T. 3 S. R. 1 E. W. M.

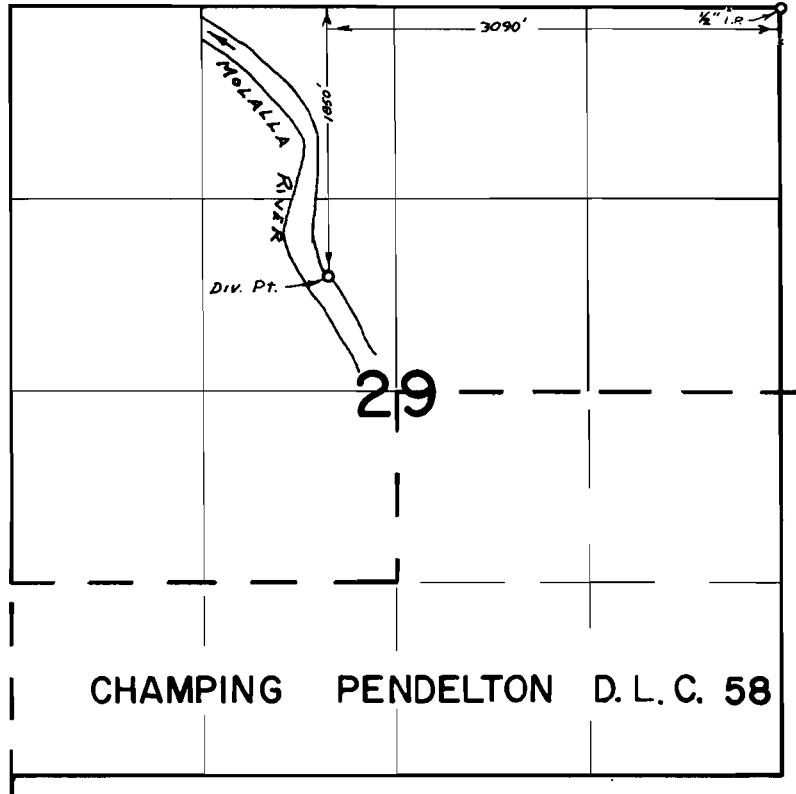

FINAL PROOF SURVEY UNDER

TRANSFER No. 2521

Application No. Permit No.
IN NAME OF

..... PAUL S. MONTECUCCO

Surveyed Sept. 12, 1972, by R. G. MURKIN