


T.15S., R.12E., W.M.

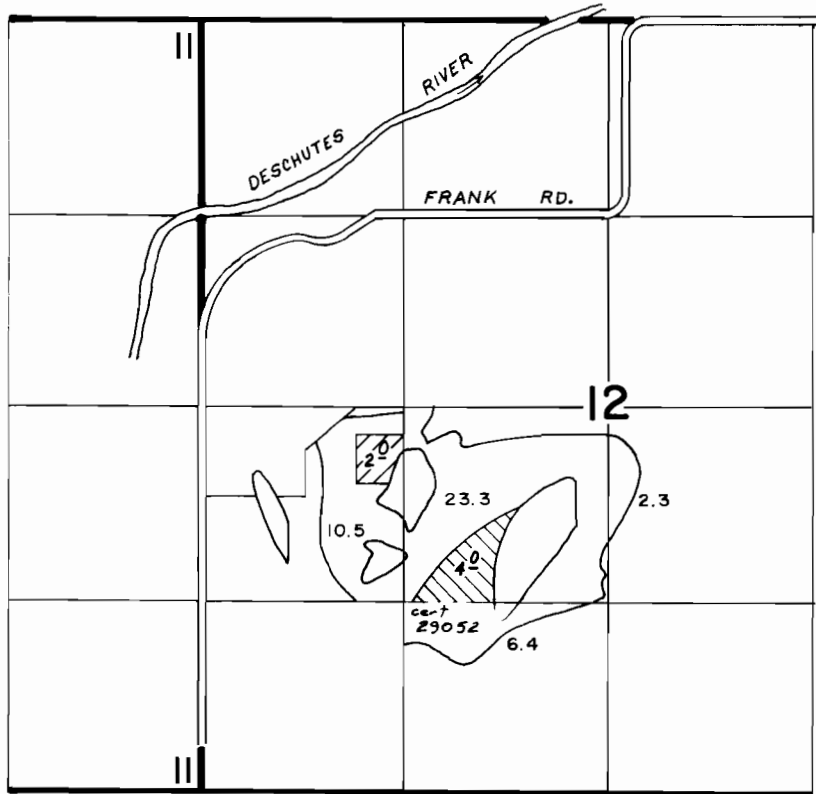

SCALE: 1" = 1320'

FINAL PROOF SURVEY

UNDER



TRANSFER NO. 2525 & 3809

Application No. Permit No.

IN NAME OF

...HARRY HEGARDT / C.O.I.D.

Surveyed AUG. 29, 1984, by LESLIE OLSON...