


T.34S. R.3.W.W.M.

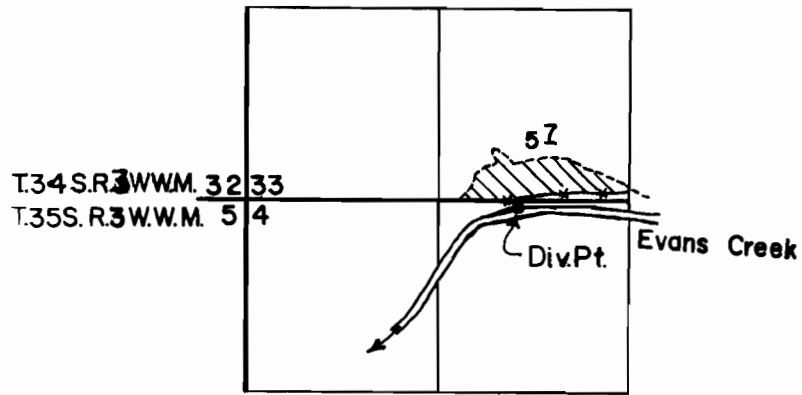

Div. pt. is 30' S & 1875' E. from
the SW. cor. of sec. 33

FINAL PROOF SURVEY UNDER

Trans. No. 2527

Application No. Permit No.

IN NAME OF

Elwyn L. & Betty M. Rowe

Surveyed Oct. 1, 1972, by L. Crow