T. 7S. R. 4W. W.M.

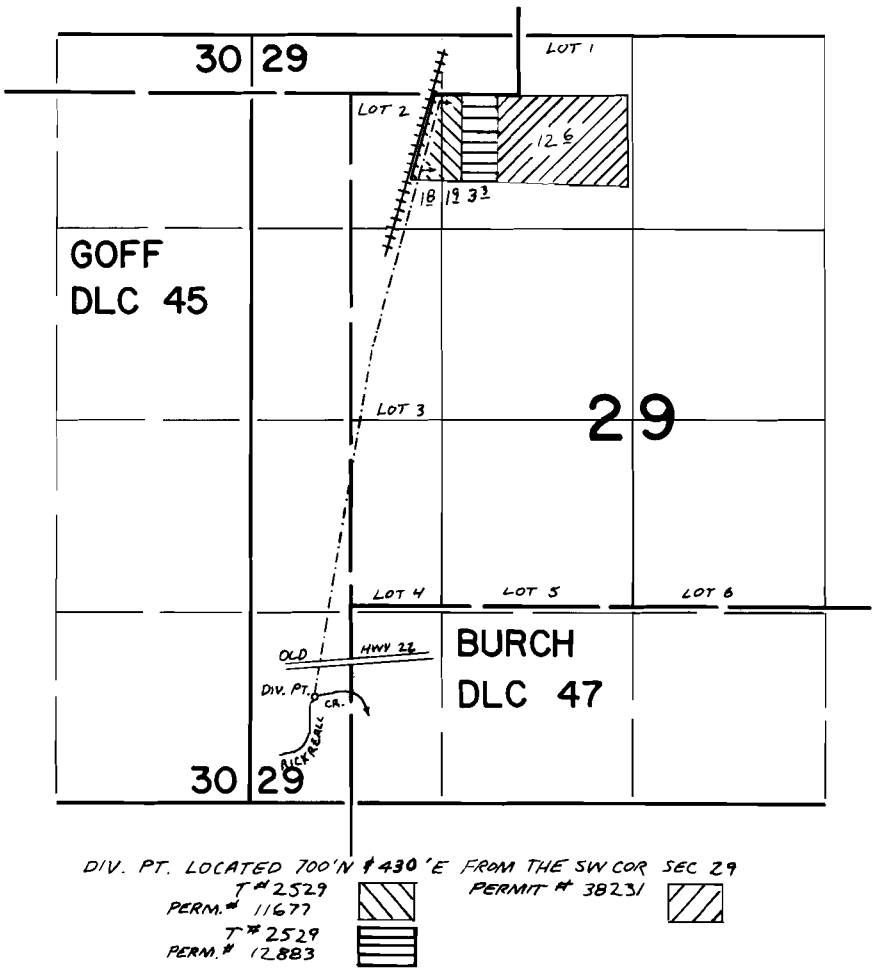

FINAL PROOF SURVEY
UNDER

Application No. T-2529 48265 Permit No. 38231
IN NAME OF

CALVIN KENNEDY

Surveyed JUNE 2 1976, by C. R. KING

DFP-LL-127
GLS