


T.11S., R.2W., W.M.

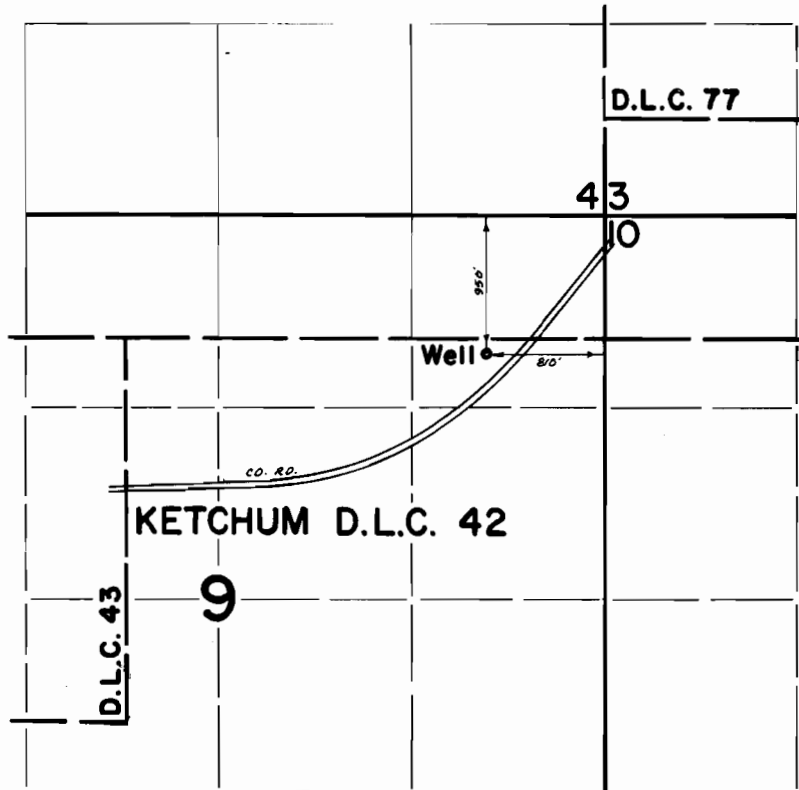

FINAL PROOF SURVEY UNDER

Transfer No. 2530

Application No. Permit No.

IN NAME OF

FLOYD LANDER

Surveyed June 18, 1973, by D. Norby