


T. 38 S., R. 1 W., W.M.

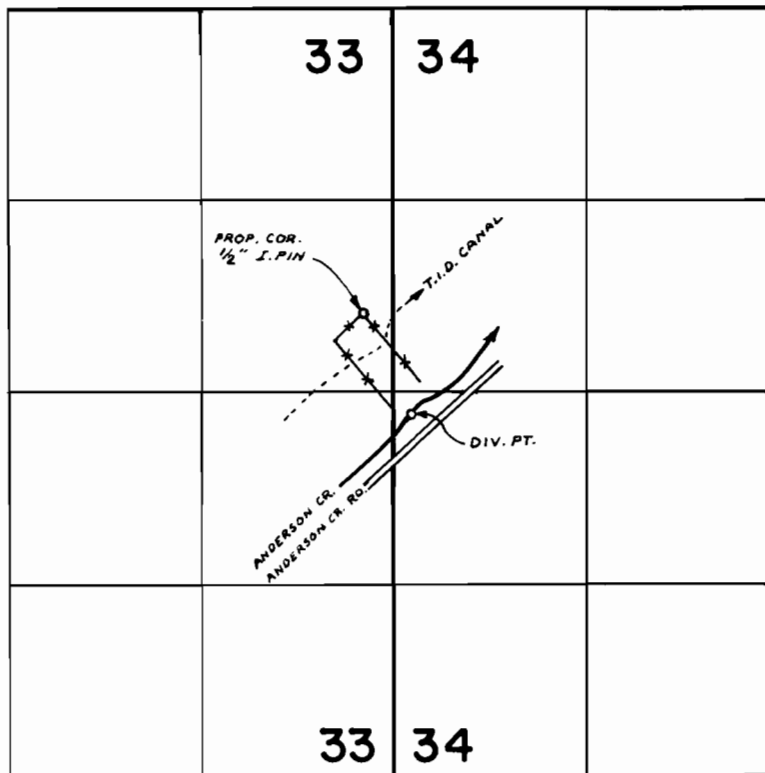

DIV. PT. LOC.: 150' S. & 120' E. FROM W. 1/4 COR. SEC. 34

FINAL PROOF SURVEY
UNDER

Transfer No. 2537

Application No. _____ Permit No. _____
IN NAME OF

DALE LEE WOODWARD

Surveyed SEPT. 28 1978, by B. SUND