


# T.36S.,R.1W.,W.M.

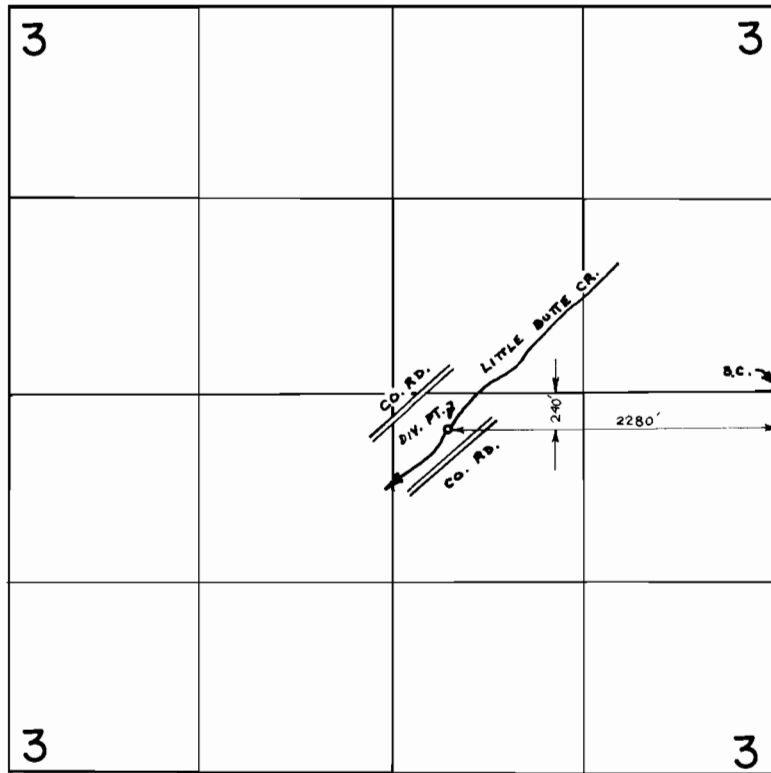

## FINAL PROOF SURVEY UNDER

Application No. T-2543 Permit No. ....

IN NAME OF

RALPH DANIEL

Surveyed AUG. 24 1978, by B. SUND