


T. 12 S. R. 1 W. W. M.

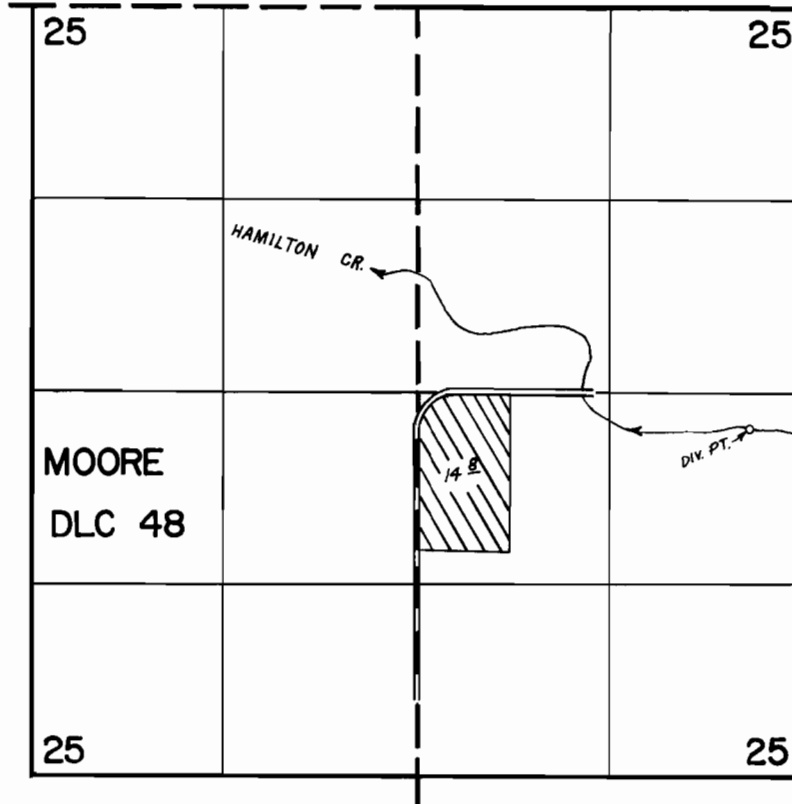

DIV. PT. 250' S & 2300' E FROM CEN. SEC 25

FINAL PROOF SURVEY
UNDER

TRANSFER NO. 2548
Application No. _____ Permit No. _____
IN NAME OF

ZELPHA M. BURIAN GILBERT

Surveyed MAY 9 1973, by R.G. MUCKEN