


# T. 12 S. R. 1 W. W. M.

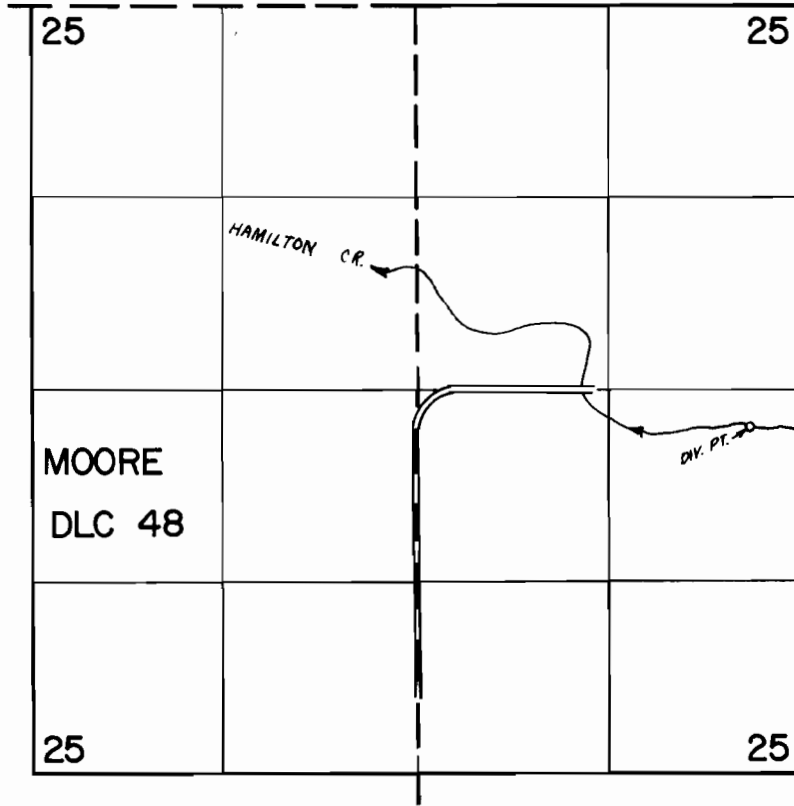

DIV. PT. 250' S & 2300' E FROM CEN. SEC 25

## FINAL PROOF SURVEY UNDER

TRANSFER NO 2549

Application No. .... Permit No. ....

IN NAME OF

A. V. GILBERT

Surveyed MAY 9 1973, by P. G. MUCKEN