


T.1N.R.4W.W.M.

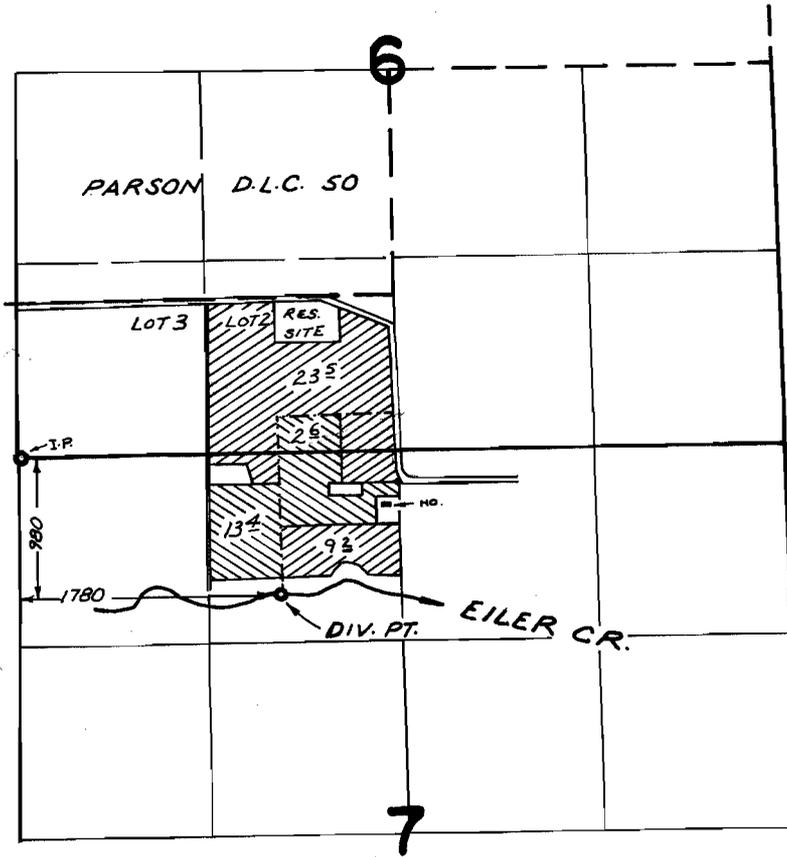

FINAL PROOF SURVEY UNDER



TRANSFER NO. 2550
Application No. 48498 Permit No. 35835
IN NAME OF

ALBERT JESSE

Surveyed NOV. 7, 1974, by R. MUCKEN