


# T.17S., R.11E., W.M.

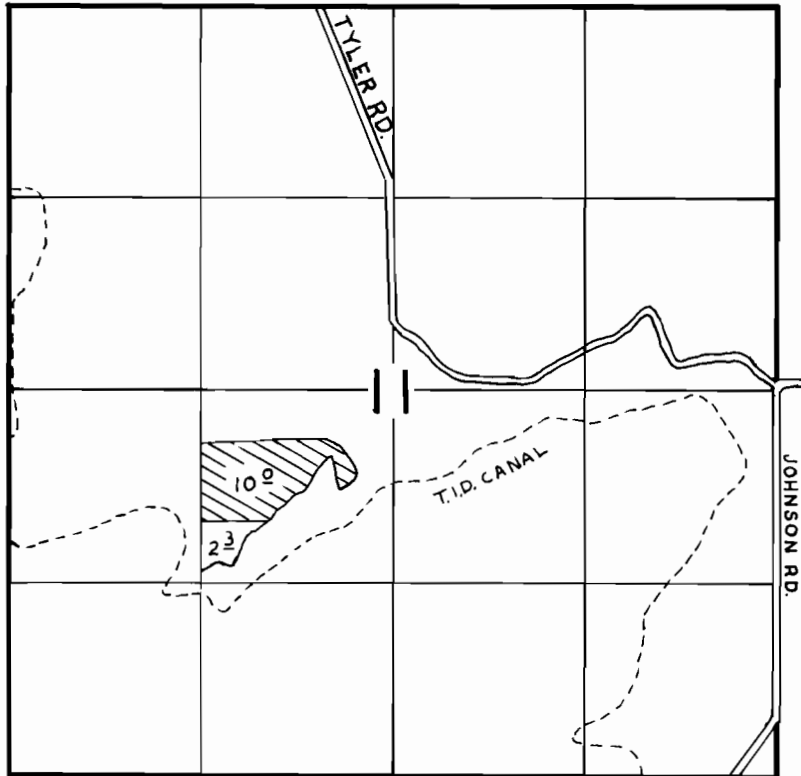

SCALE : 1" = 1320'

## FINAL PROOF SURVEY UNDER

TRANSFER NO. 2558

IN NAME OF

**TED LYSTER**

Surveyed NOV. 7, 1985, by LESLIE OLSON