


T.16S., R.12E., W.M.

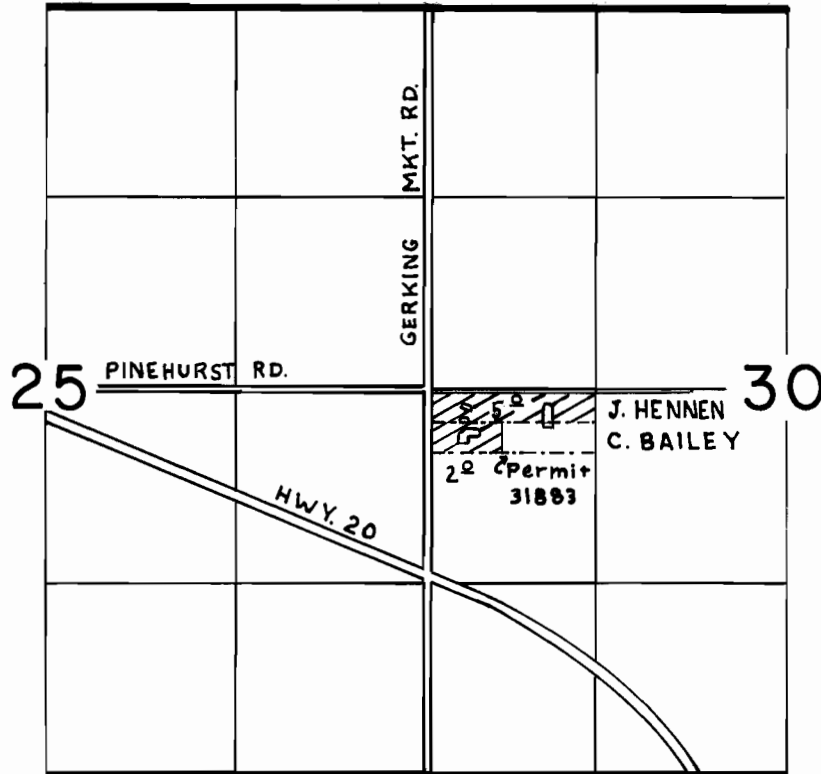

SCALE : 1" = 1320'

FINAL PROOF SURVEY
UNDER


PART OF TRANSFER NO. 2559

IN NAME OF

CLARENCE BAILEY & JACK HENNER

Surveyed JULY 18, 1985, by LESLIE OLSON...

T.17S., R.11E., W.M.

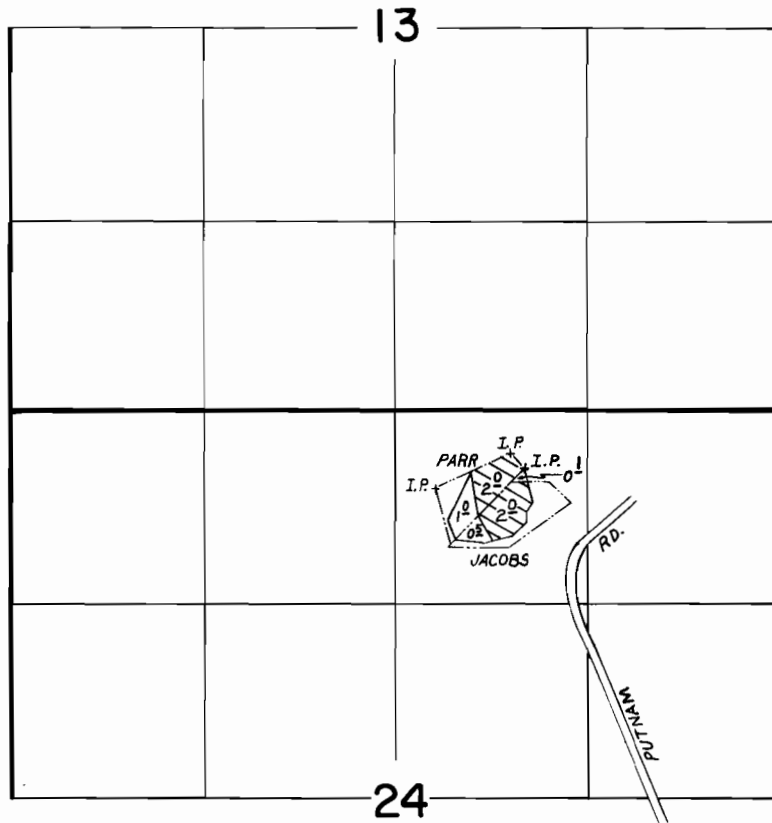

SCALE: 1" = 1320'

FINAL PROOF SURVEY

UNDER


PART OF
TRANSFER NO. 2559

IN NAME OF

ROBERT PARR & ALBERT JACOBS.....

Surveyed APRIL 11, 1985, by TIM W. BURKS.....

T.16S., R.12E., W.M.

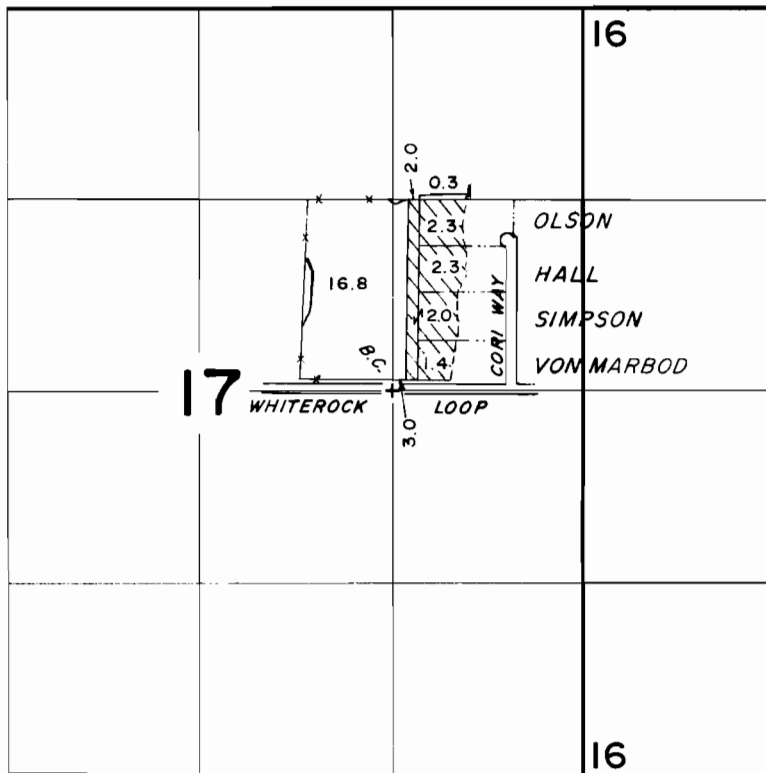

FINAL PROOF SURVEY UNDER

PART OF TRANSFER 2559
Application No. Permit No.
IN NAME OF

...OLSON, HALL, SIMPSON & VON MARBOD...

Surveyed AUG. 5..... 19.82, by L.H. NUNN.....