


Sec 34

TWP 16

RANGE 11

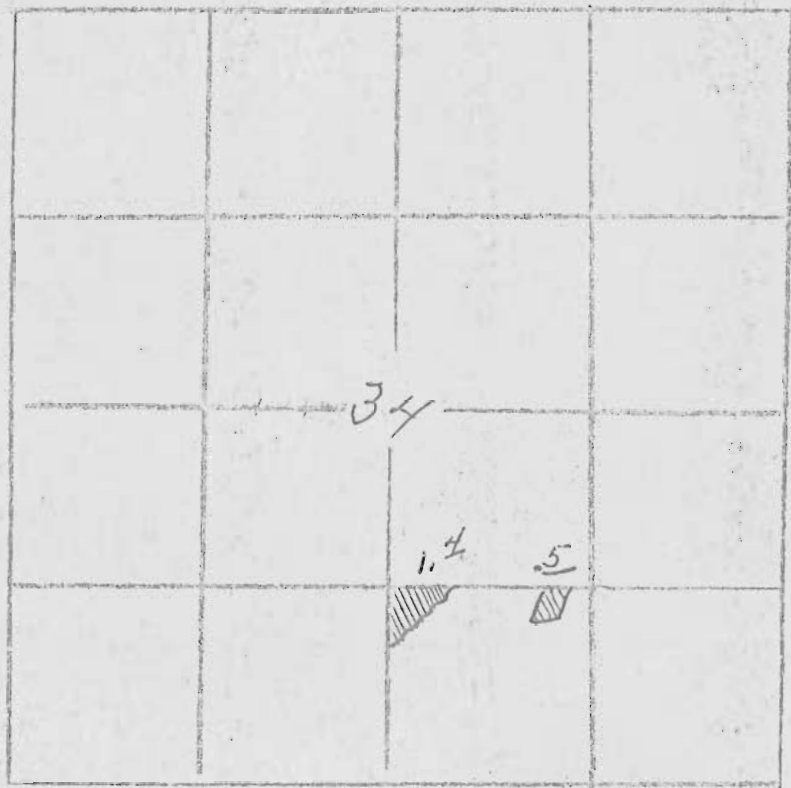


Transfer to SW 1/4 SE 1/4 1⁹ ACRES

Transfer from SE 1/4 NW 1/4 Sec 35-16-11

Sec. 35

TWP 16

RANGE 11

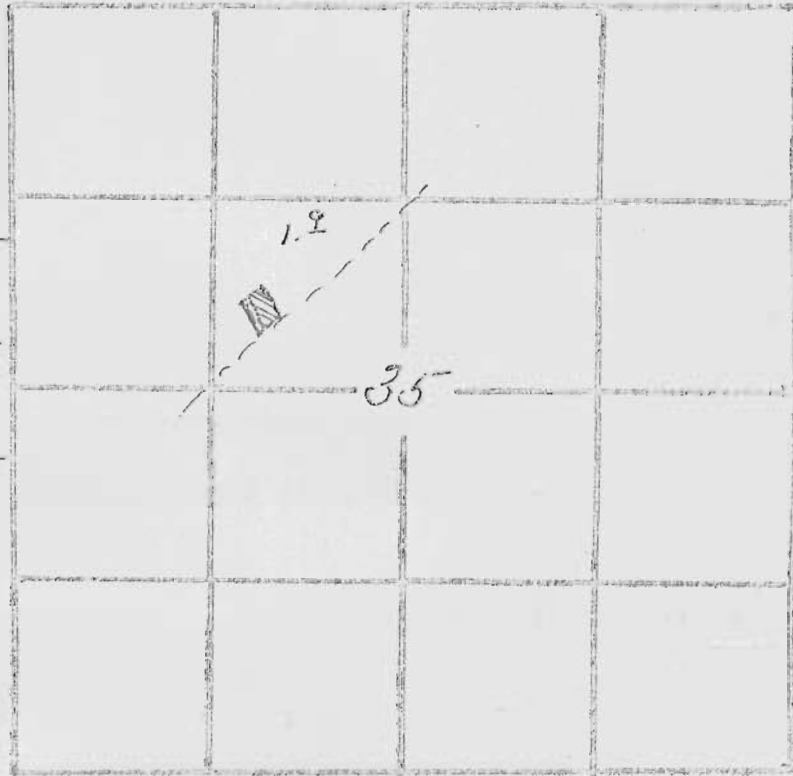

PRIMARY RIGHT
 CERT # 19628-26050
 Date Oct 27, 1913

Supplemental right
 Permit # 624
 Cert 26051
 Date April 7, 1911

Supplemental Right
 Cert # 31412
 Date - 1905

Transferred 1st 9 from SE 1/4 NW 1/4

Transferred to SW 1/4 SE 1/4 Sec 34 TWP 16 RAN

RECEIVED
 SEP 27 1971
 STATE ENGINEER
 SALEM, OREGON

NEW