


T.13S.,R.34E.,W.M.

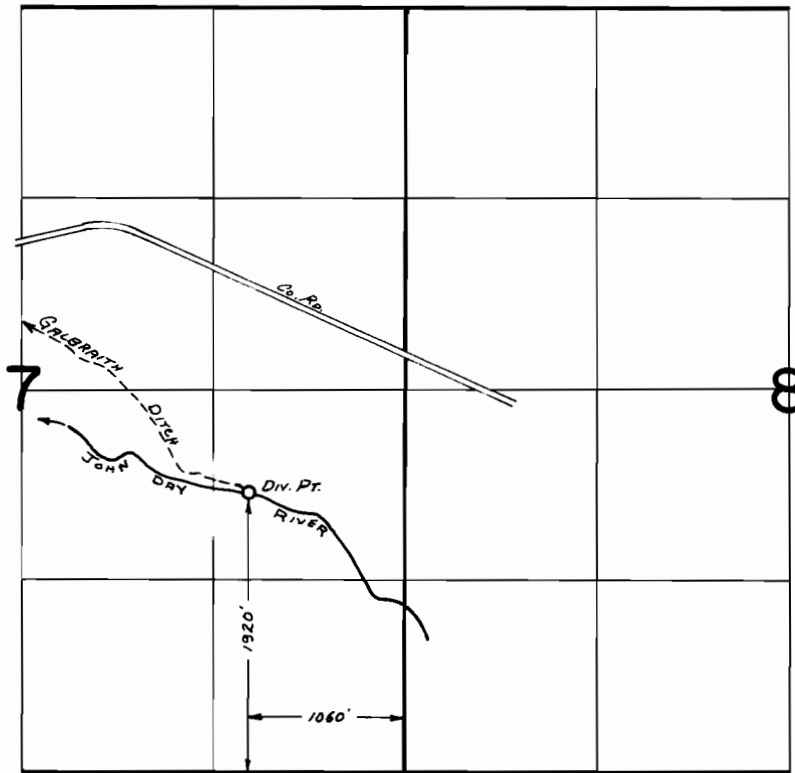

FINAL PROOF SURVEY
UNDER

Transfer No. 2566
Application No. Permit No.
IN NAME OF

ROBERT JOHNSON

Surveyed Aug. 27, 1981, by S. C. BROWN