


T. 40S., R. 8 W., W.M.

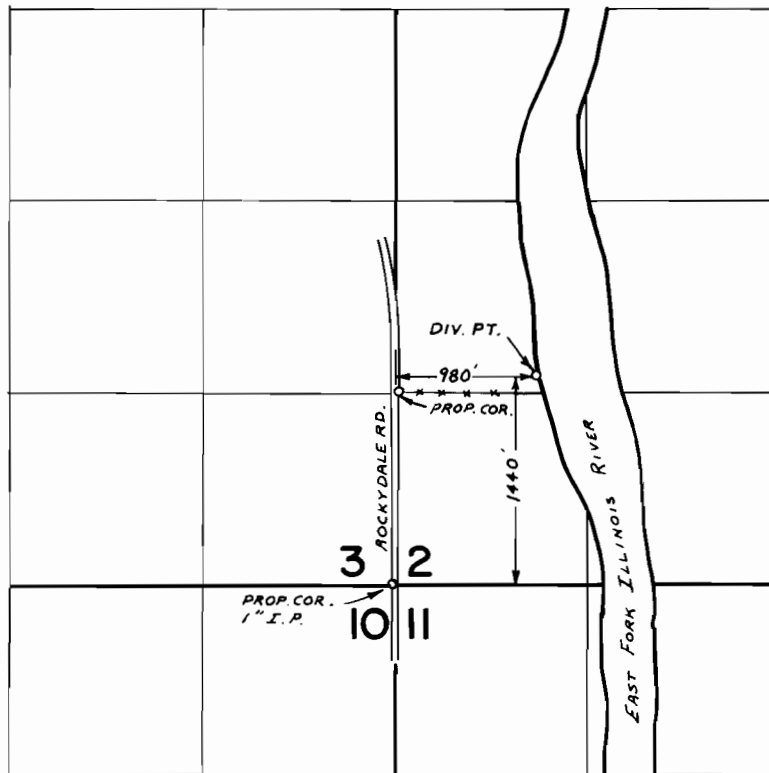

Scale 4" = 1 mile

FINAL PROOF SURVEY UNDER

Transfer no. 2579

Application No. Permit No.
IN NAME OF

Wilber G. & Myra P. Bickmore.....

Surveyed April 30, 1980, by B.R. SUND.....