


# T.39 S.R.2W.W.M.

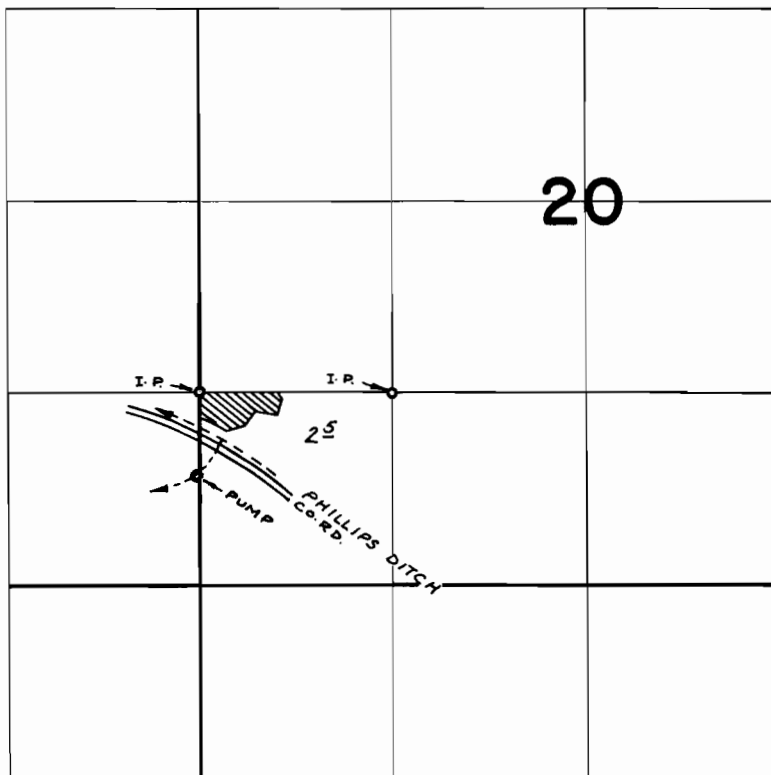

## FINAL PROOF SURVEY UNDER

TRANSFER NO. 2580

Application No. .... Permit No. ....  
IN NAME OF

.....STUART V. HINSON.....

Surveyed SEPT. 26, 1974, by R. MUCKEN