


T.23S. R.10E. W.M.

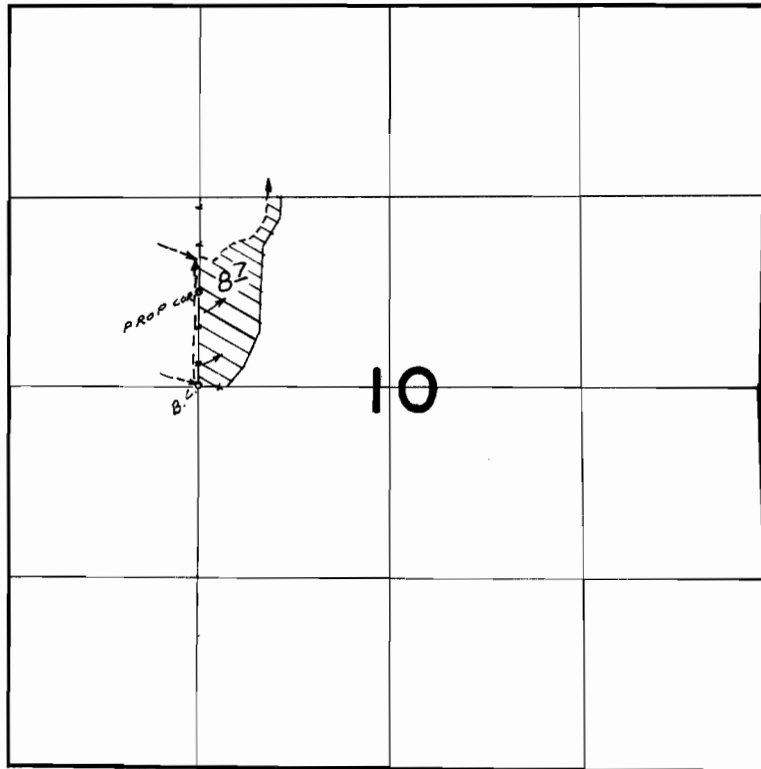

FINAL PROOF SURVEY
UNDER

Transfer No. 2581

Application No. Permit No.

IN NAME OF

DONALD J. MENG

ELLYN, SPIROS, & THEO. COREN

Surveyed JUN. 13, 1975, by L.H. NUNN