


T.9S. R.40E. W.M.

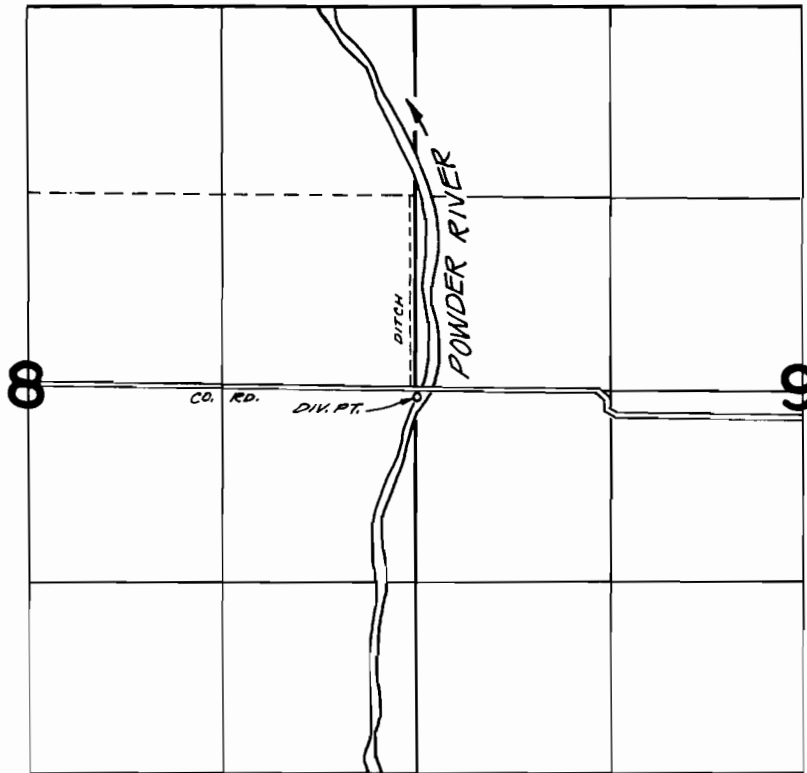

DIV. PT. LOCATED 50' S., 20' E FROM W 1/4 COR. SEC. 9

**FINAL PROOF SURVEY**  
UNDER

TRANSFER NO. 2582  
Application No. \_\_\_\_\_ Permit No. \_\_\_\_\_  
IN NAME OF  
CLYDE WARD

Surveyed OCT 29 1974, by L.M. TOLL