


T.29S.,R.4W.,W.M.

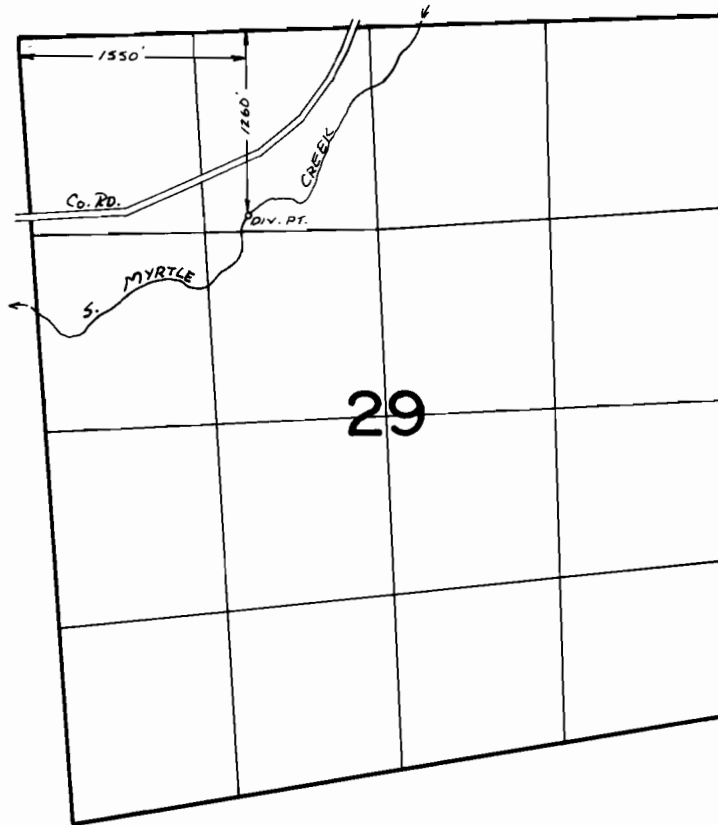

FINAL PROOF SURVEY UNDER

Transfer No. 2587

Application No. Permit No.

IN NAME OF

..... VERN J. LIVELY

Surveyed July 24 1975, by L. E. Gould