


T. 38 S., R. 8 W., W.M.

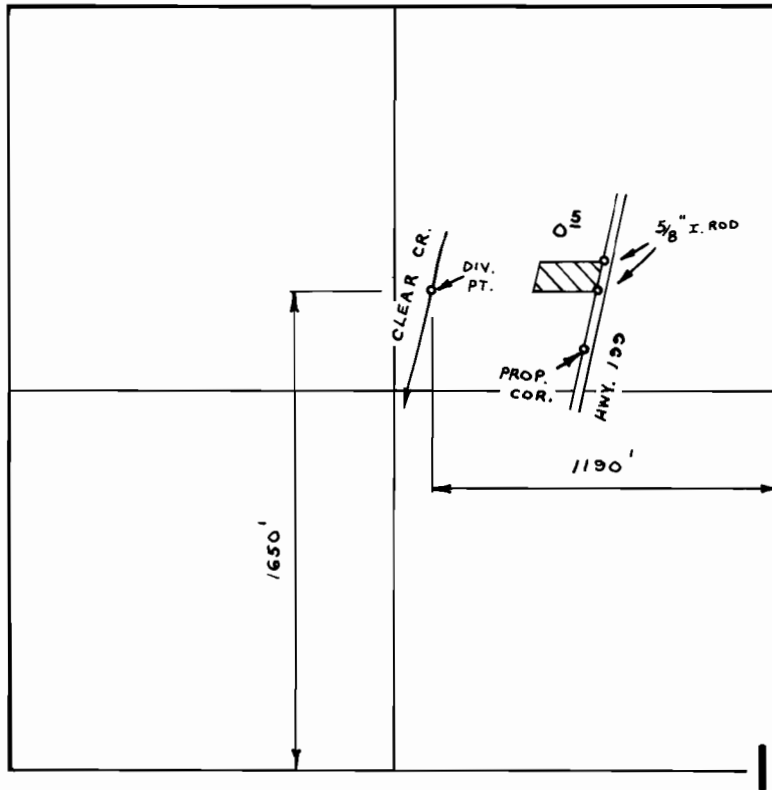

SCALE : 1" = 660 FT.

FINAL PROOF SURVEY UNDER

Transfer No. 2591
Application No. Permit No.
IN NAME OF

R. L. HAMMER

Surveyed JUL. 17 1978, by B. SUND

D.H.M.

P.T.S. - 1978-14 - A