


T.16S. R.12E. W.M.

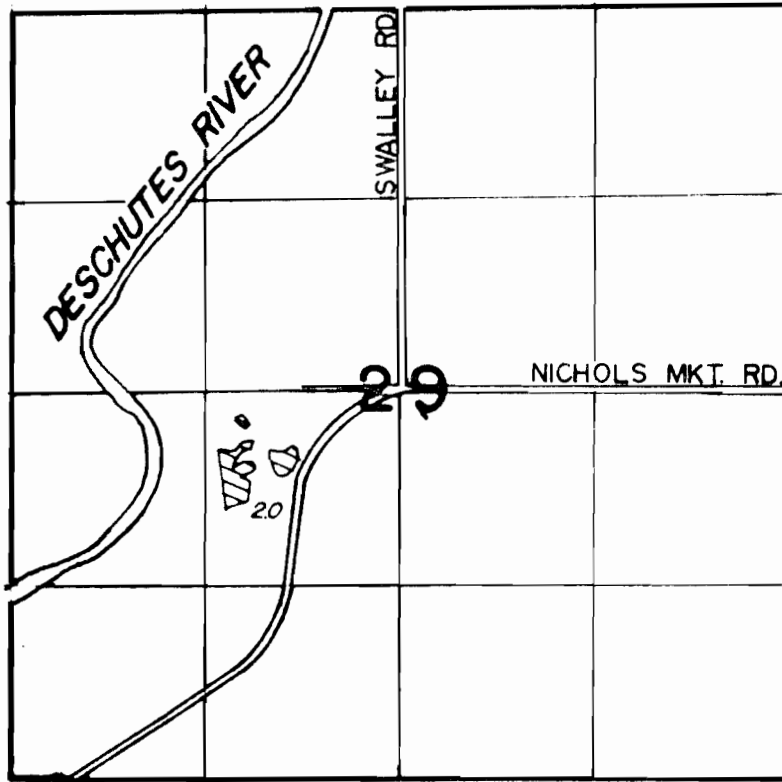

PRELIMINARY
SUBJECT TO REVISION

FINAL PROOF SURVEY
UNDER

PART OF TRANSFER 2594

Application No. Permit No.
IN NAME OF

WILLIAM BOYD

Surveyed JUN. 1..... 1983., by L.H. NUNN.....