


T.14S., R.14E., W.M.

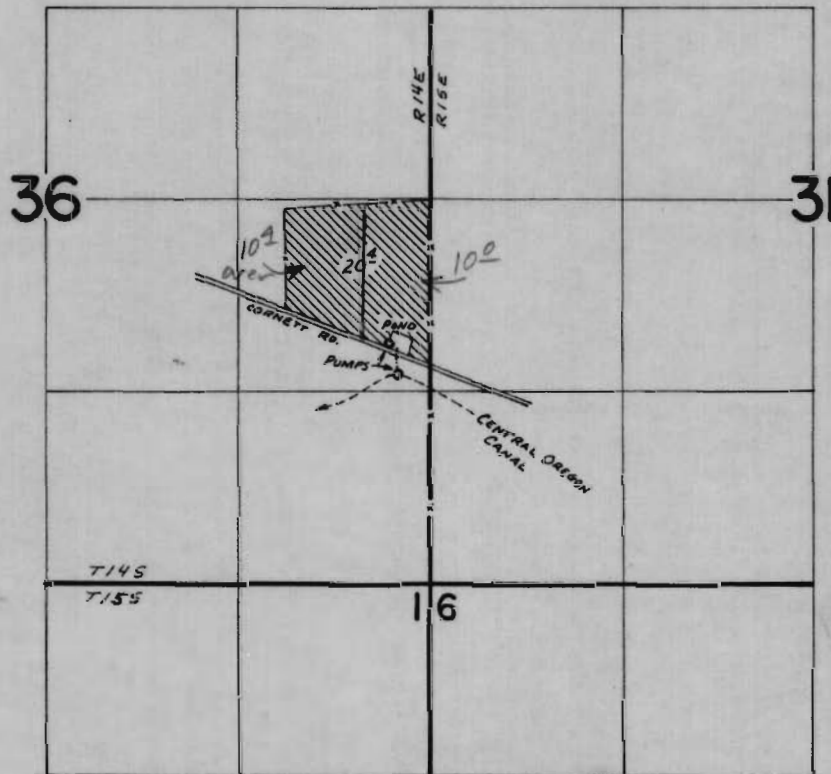

FINAL PROOF SURVEY
UNDER

Transfer No. 2599

Application No. _____ Permit No. _____

IN NAME OF

HENRY W. KNOCHE

Surveyed May 12 1975, by O. Norby