


T.14S. R.13E. W.M.

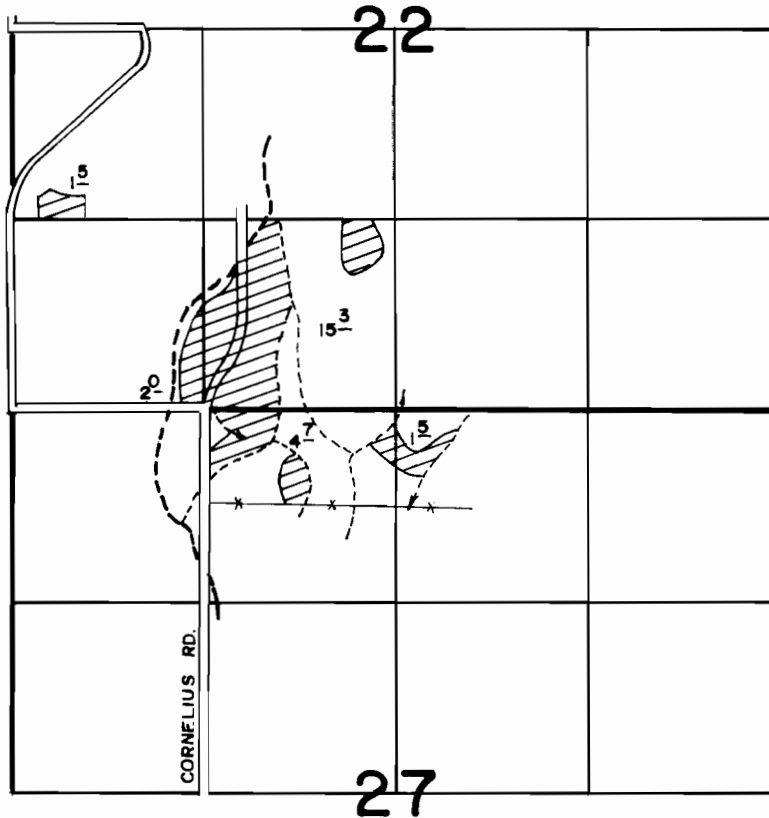

FINAL PROOF SURVEY
UNDER

TRANSFER NO. 2601

Application No. Permit No.

IN NAME OF

.....**TOMMYE G. FLENNKEN**.....

Surveyed **MAY 7**..... 1981....., by **L.H. NUNN**.....