

6

5

209

249

189

7

CANAL

239

349

289

289

399

219

139

319

379

309

399

389

239


11

13

09


RECEIVED
FEB 28 1972
STATE ENGINEER

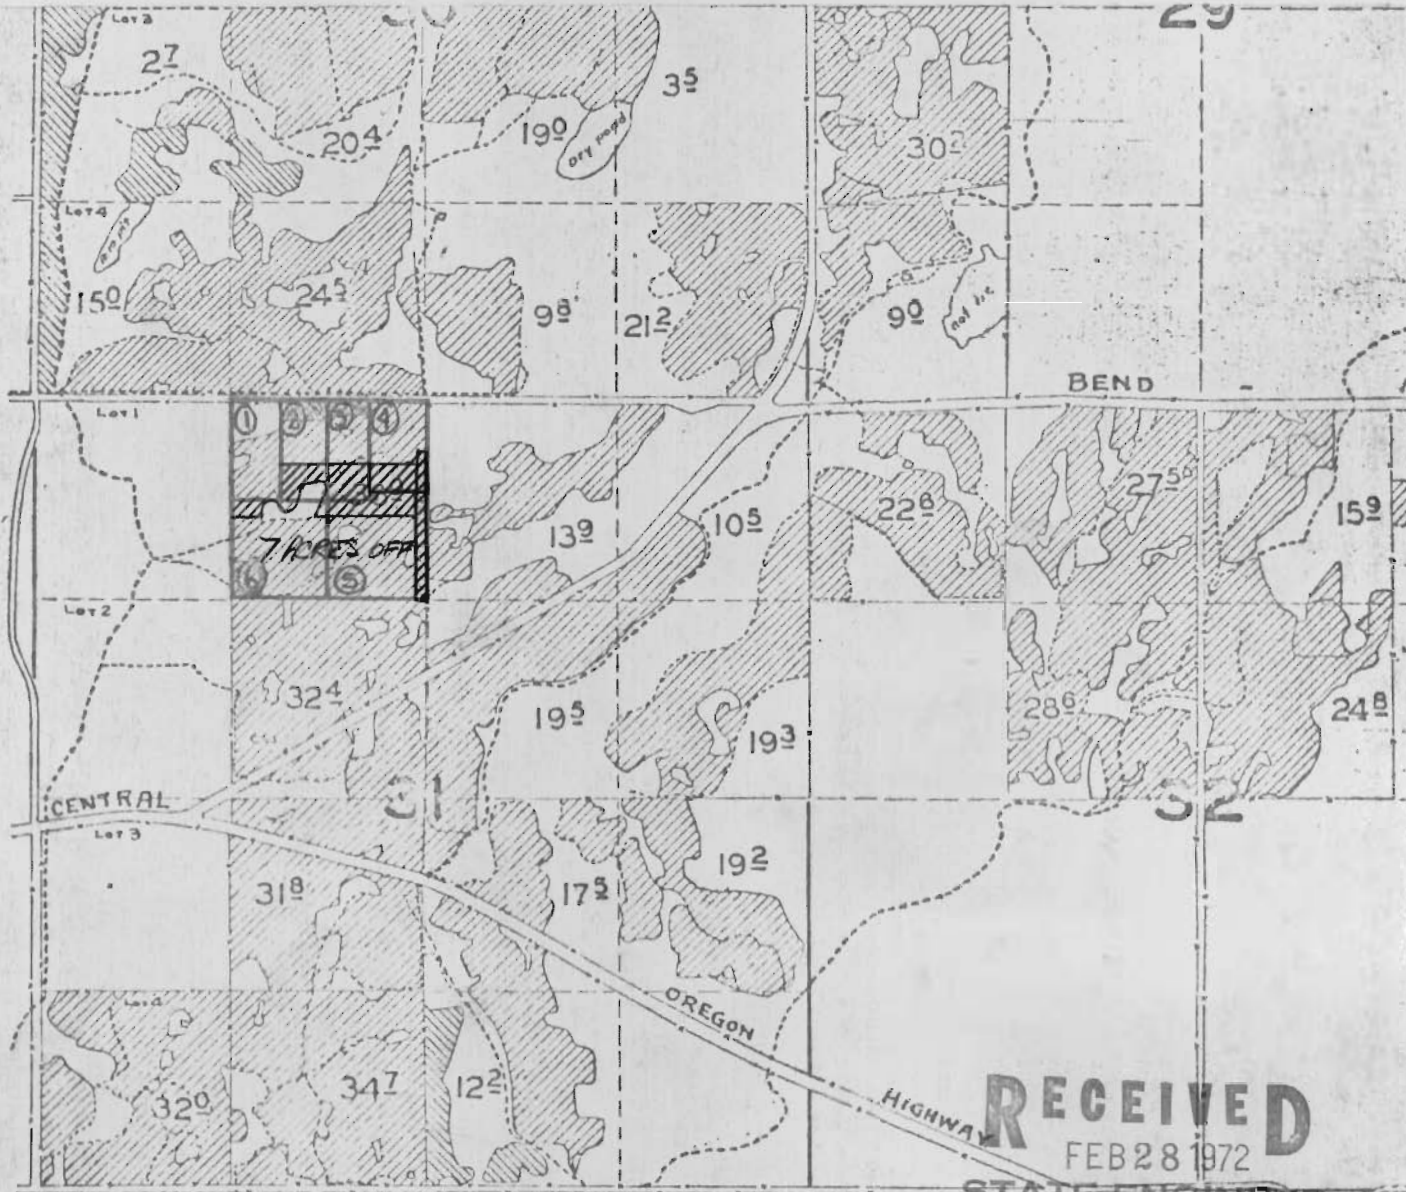

RECEIVED
FEB 28 1972
STATE ENGINEER
SALEM, OREGON