


T.6S.,R.6W.,W.M.

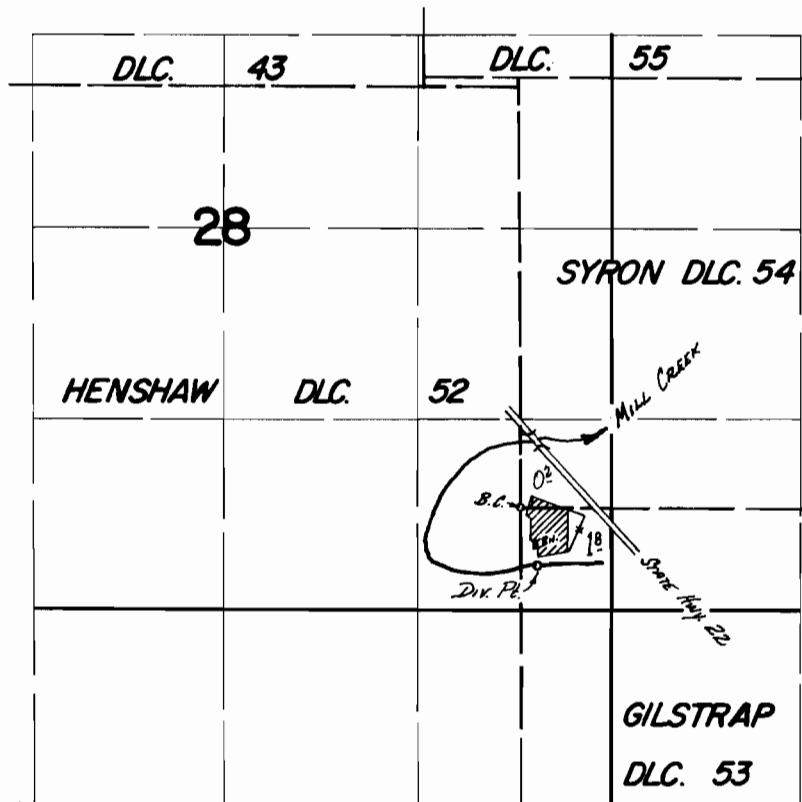

Dike Pt. Loc.: 400' S. & 120' E. FROM NW COR. GILSTRAP DLC. 53.

FINAL PROOF SURVEY
UNDER

Transfer No. 2614

Application No. _____ Permit No. _____

IN NAME OF

CHARLES H. JONES

Surveyed May 8 1973, by D. Noesey