


Township 5 South, Range 1 West, W.M.

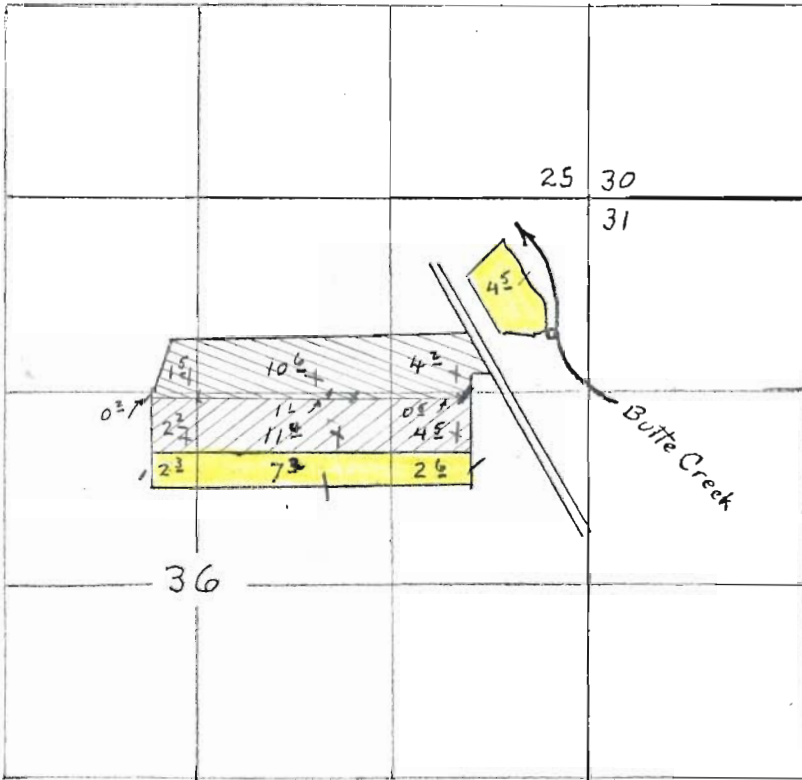

Lands with a priority
of April 12, 1961
being transferred.

FROM :



TO :



Lands not affected by this change.

