


T. 38 S., R. 8 W., W.M.

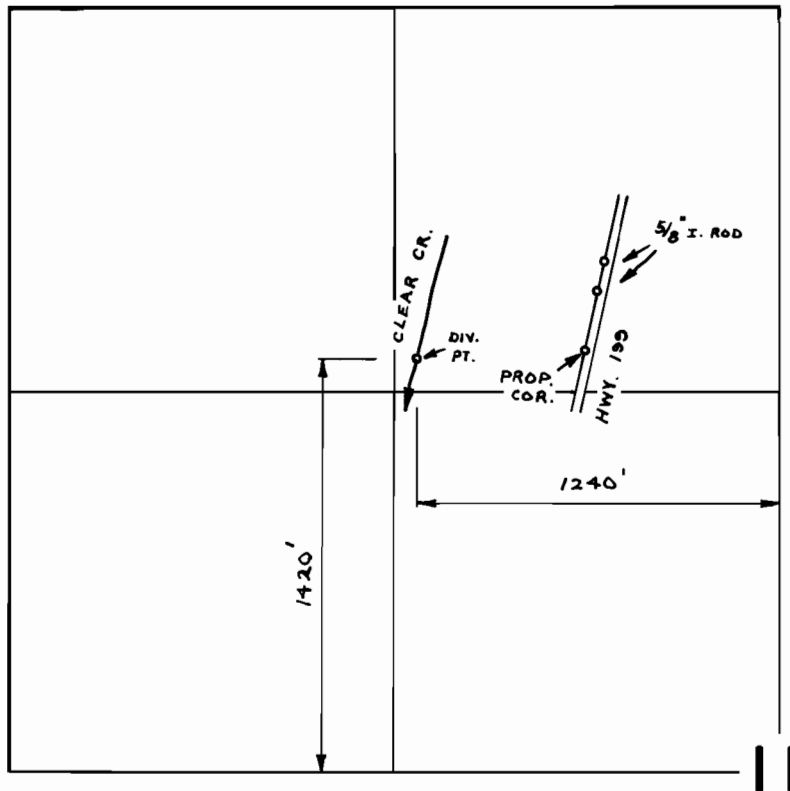

SCALE: 1" = 660 FT.

FINAL PROOF SURVEY UNDER

Transfer No. 2631

Application No. Permit No.

IN NAME OF

WARREN S. & VIRGINIA B. MORSE

Surveyed JUL. 17 1978, by B. SUND

D.H.M.

P.T.S.-1978-14-A