



PROPOSED PLACE OF USE - "RECREATION"

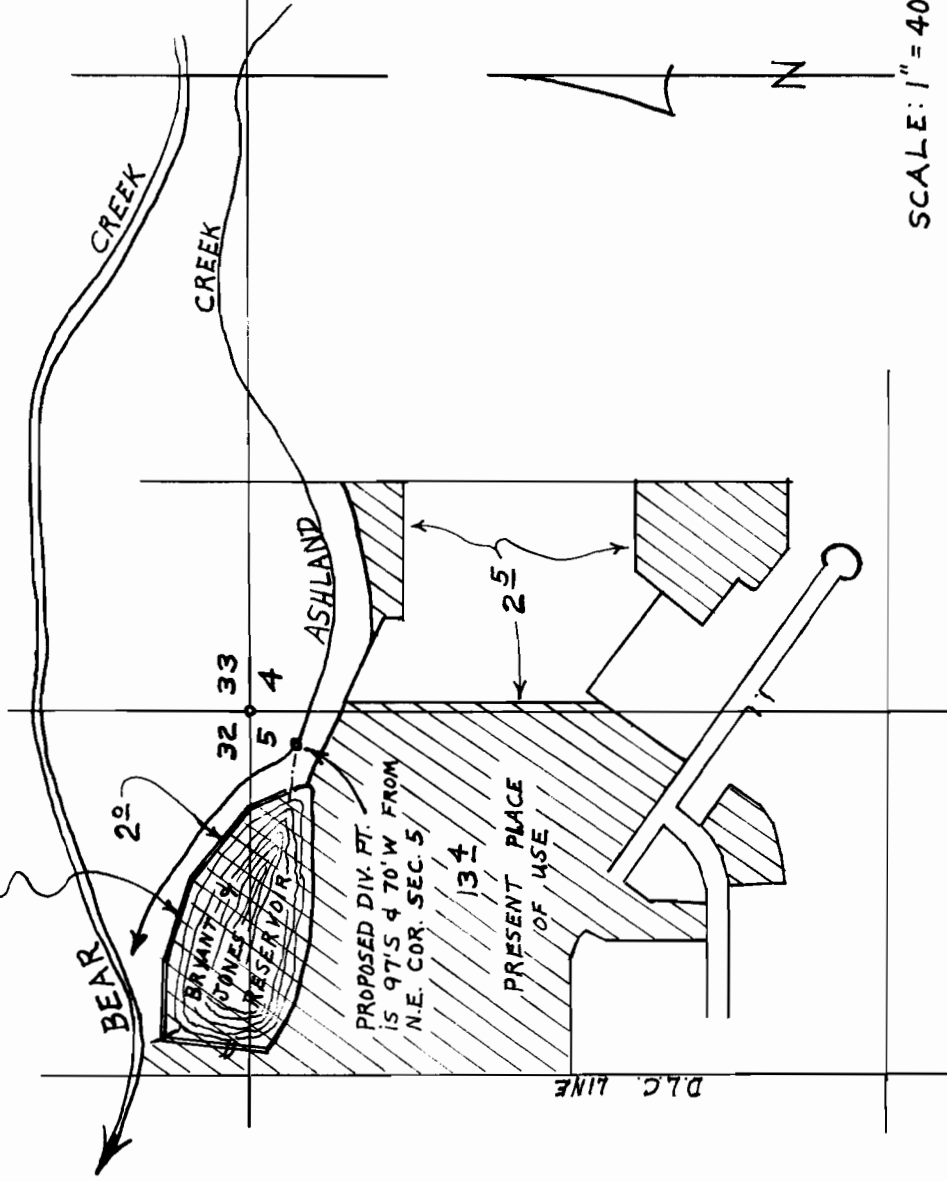


T.38 S. R. 1 E. W. M. 33 4
T.39 S. R. 1 E. W. M. 33 4

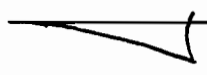

SCALE: 1" = 400'

T 39 S., R 1 E.

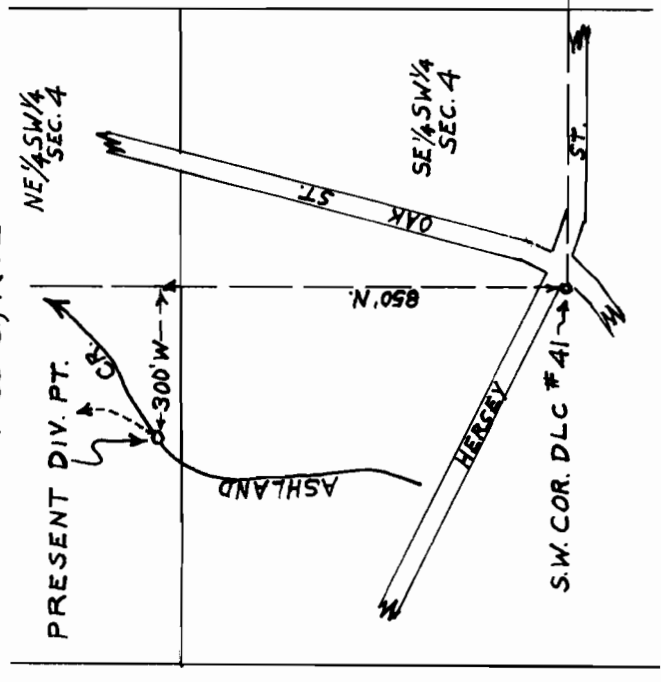

KENNETH H. JONES AND PHILLIP F. BRYANT

FOR CHANGE IN POINT OF DIVERSION, PLACE OF USE AND CHARACTER OF USE.