


T. 2S. R. 44E. W.M.

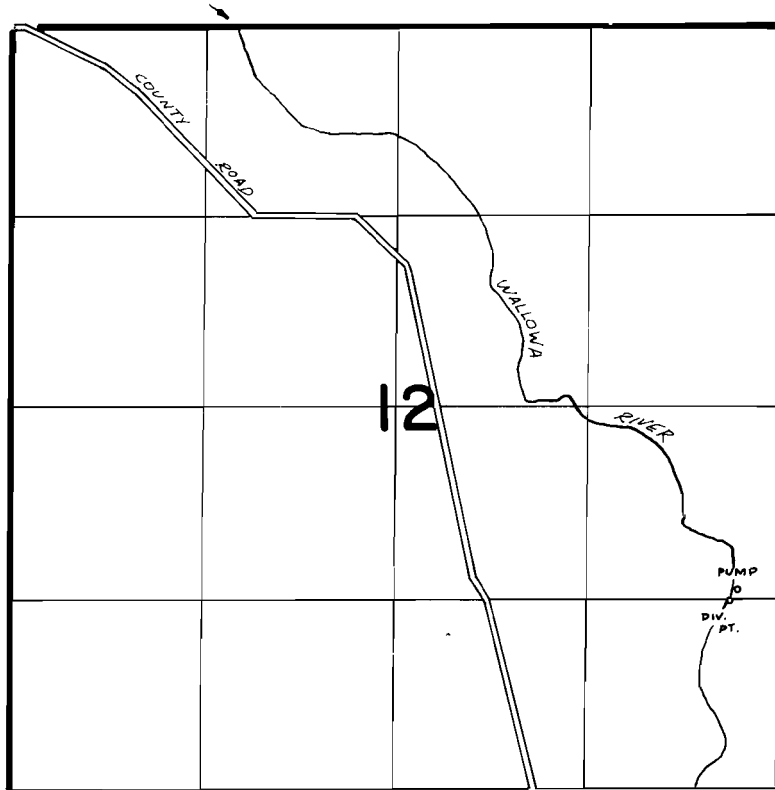

DIVERSION POINT LOCATED 1310' N. & 350' W. FROM SE COR SEC 12

FINAL PROOF SURVEY
UNDER

TRANSFER 2648

Application No. _____ Permit No. _____
IN NAME OF

E. JUSTIN SNYDER

Surveyed 8-23 1978 by R. BARWILL