


T. 4N. R. 27E. W.M.

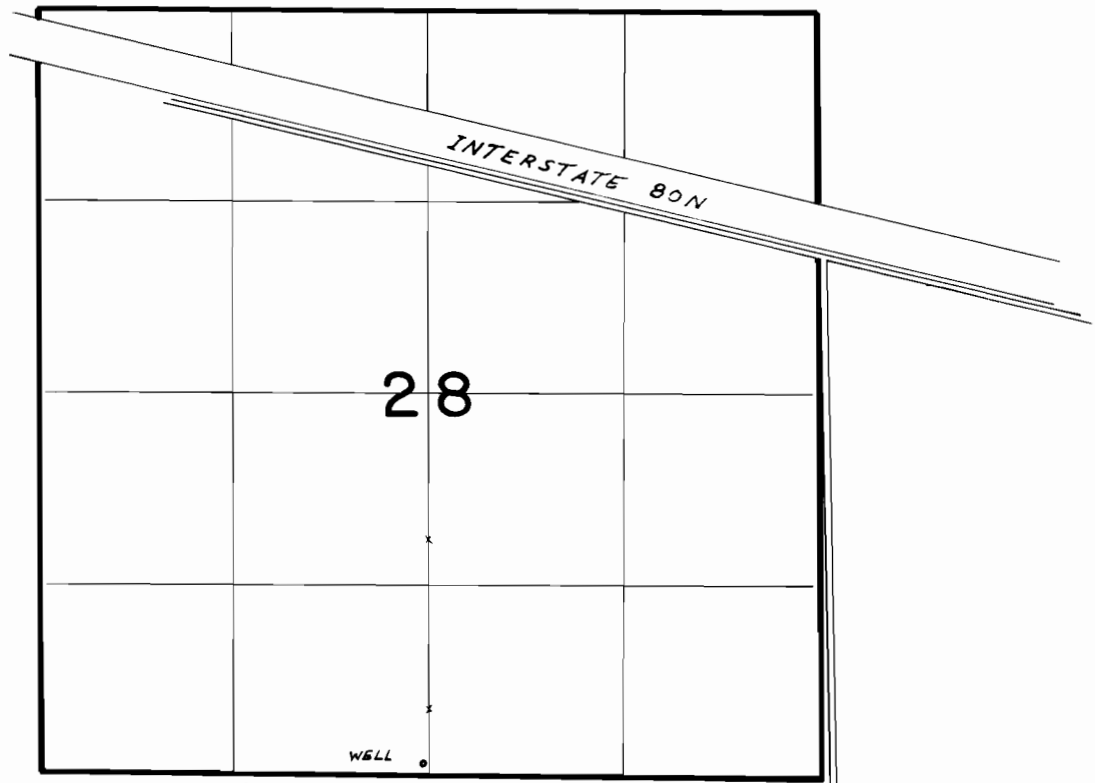

WELL LOC. 90'N & 40'W FROM S 1/4 COR SEC 28

FINAL PROOF SURVEY
UNDER

TRANSFER 2649

Application No. Permit No.
IN NAME OF

J. W. AYLETT

Surveyed 8-9 1978, by R. BARWIN