


T.2N.R.4&5W.W.M.

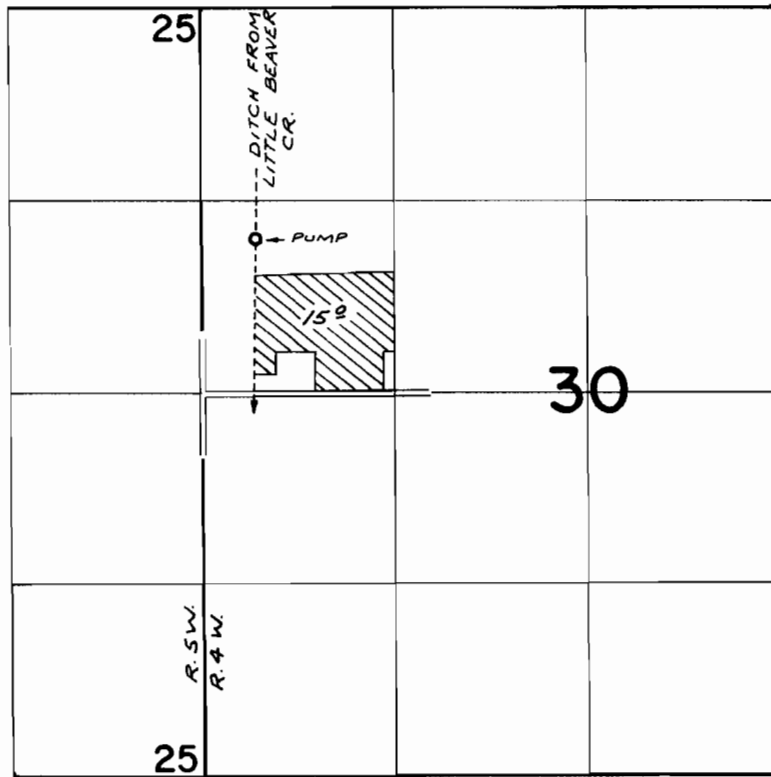

FINAL PROOF SURVEY
UNDER

TRANSFER NO. 2663
Application No. Permit No.
IN NAME OF

..... MATTHEW S. KEMPER

Surveyed APR. 5, 1974, by R. MUCKEN