ROBERT D. and EARLEEN L. FOX
ROUTE 3, BOX 85A3
SCIO, OREGON 97374

SECTION 28, TOWNSHIP 10 S., RANGE 2 W. WM
SCALE 1 INCH = 660 FEET
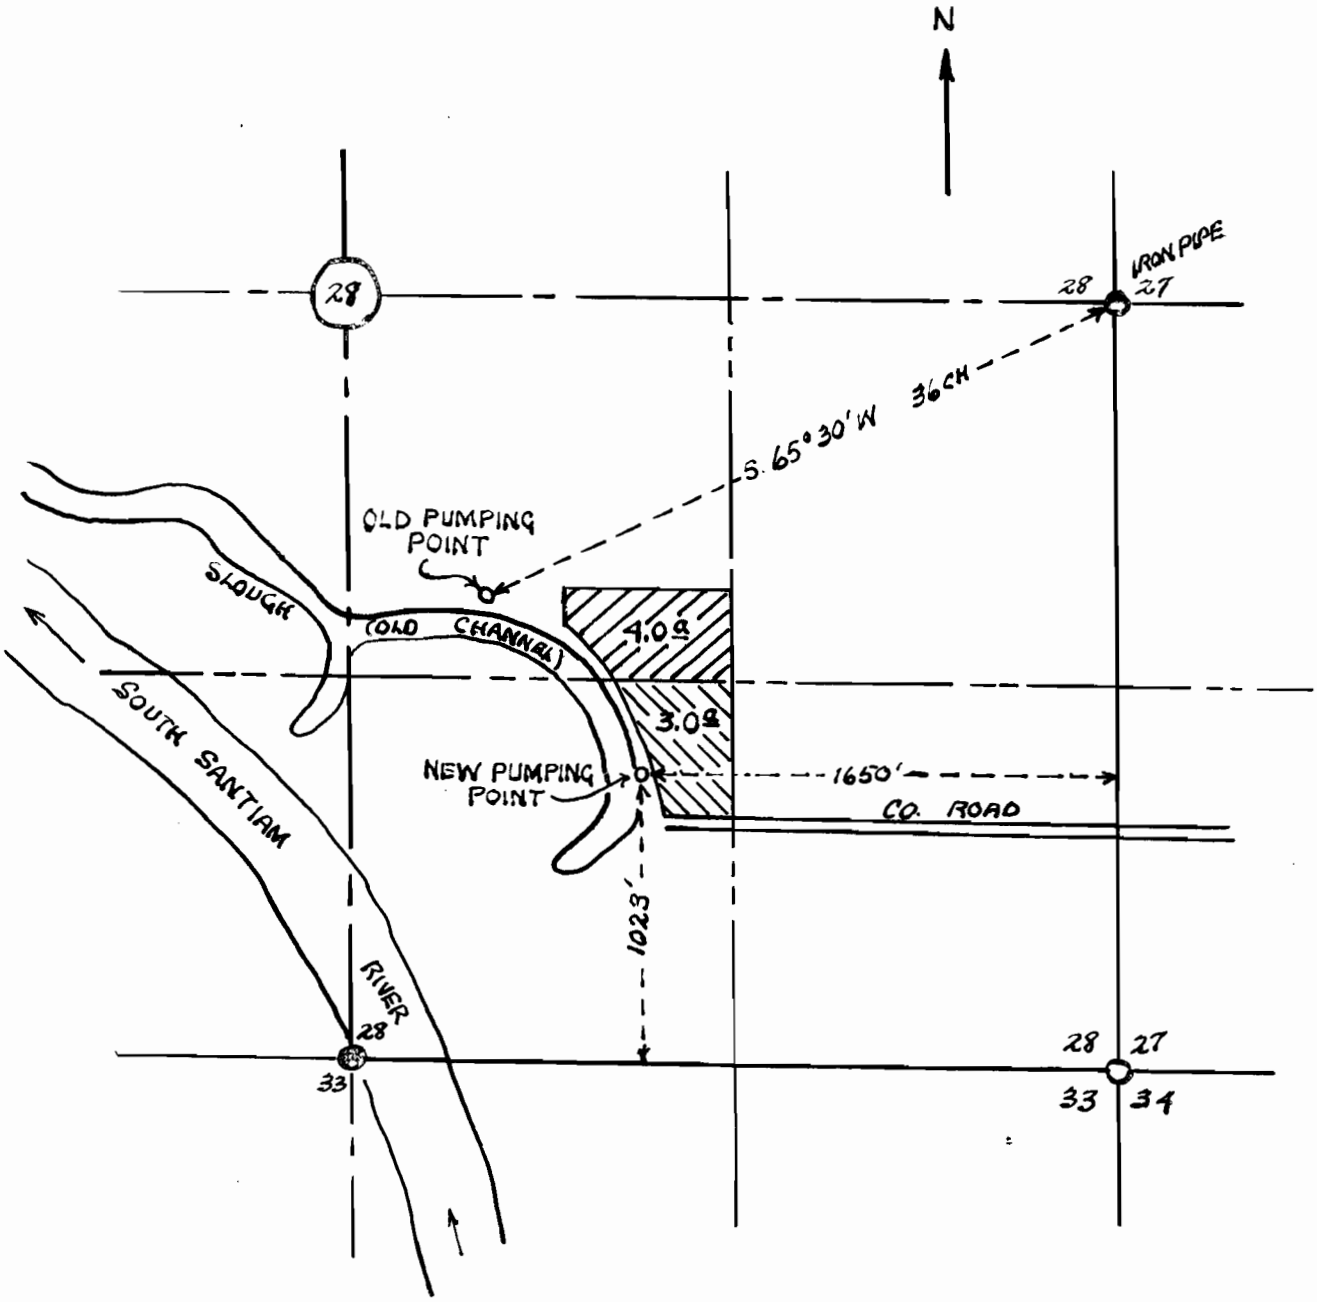
MAP DRAWN FROM WR 453 PREPARED BY
ORRIS A. CARNEGIE, LINN COUNTY SURVEYOR.