


T.36S.,R.IW.,W.M.

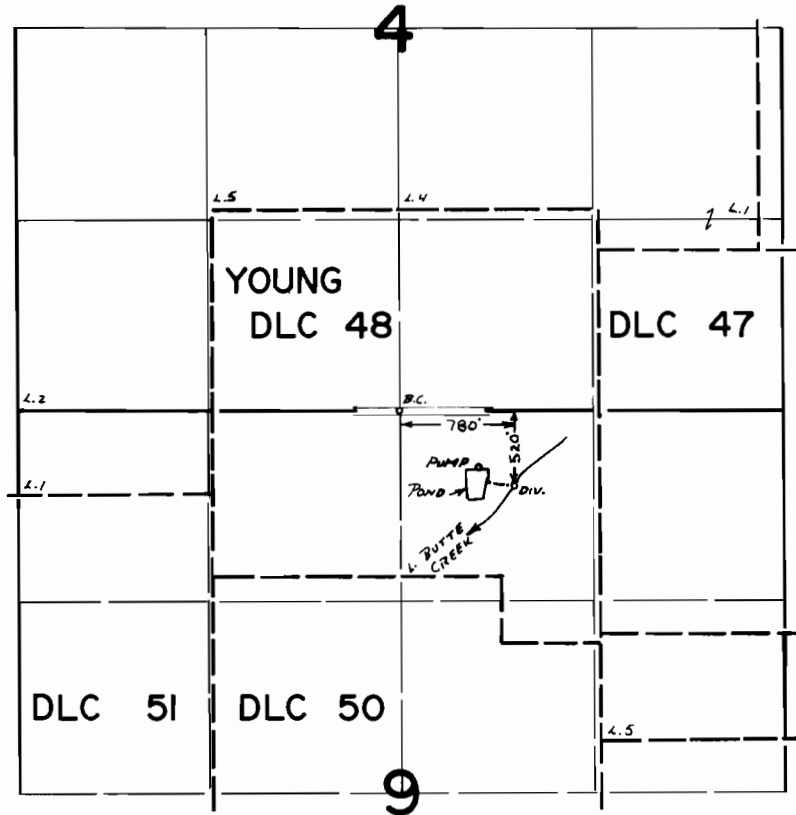

FINAL PROOF SURVEY UNDER

Transfer No. 2672
Application No. Permit No.
IN NAME OF

BURTON. C. & DELTA L. JENSEN

Surveyed Aug. 18. 1975, by L. E. GOULD