


T. 1N., R. 4W., W.M.

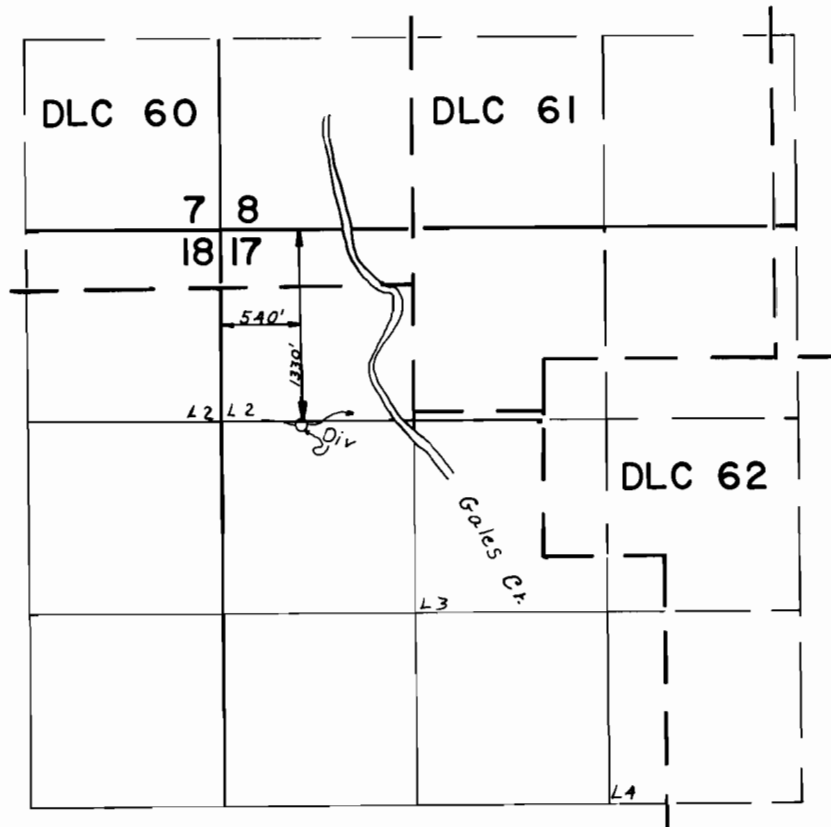

FINAL PROOF SURVEY
UNDER

TRANSFER NO. 2677

Application No. Permit No.

IN NAME OF

THEODORE J. SPIDAL

Surveyed MAY 18, 1976, by R.G. MUCKEN